


# T. 10 S. R. 2 W. W. M.

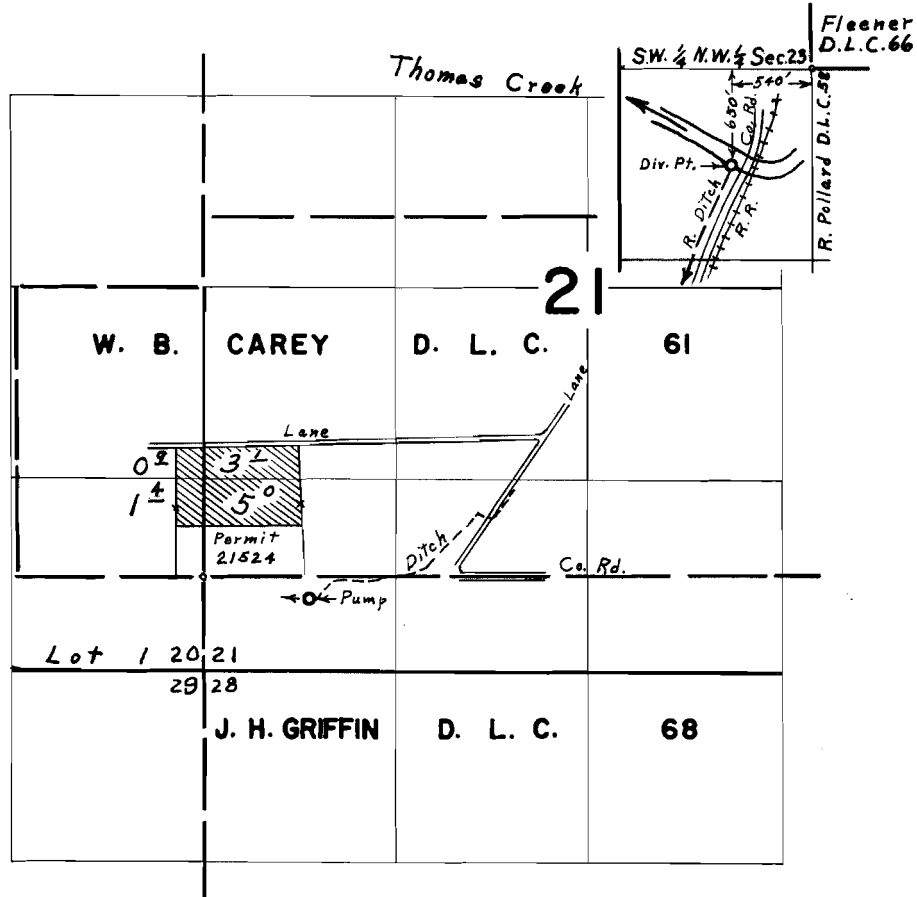

## FINAL PROOF SURVEY UNDER

Application No. 39910 Permit No. 29837  
IN NAME OF

RIVERVIEW DITCH ASSOCIATION

Surveyed Nov. 3, 1967, by L. E. Gould