


T.15S.R.42E.W.M.

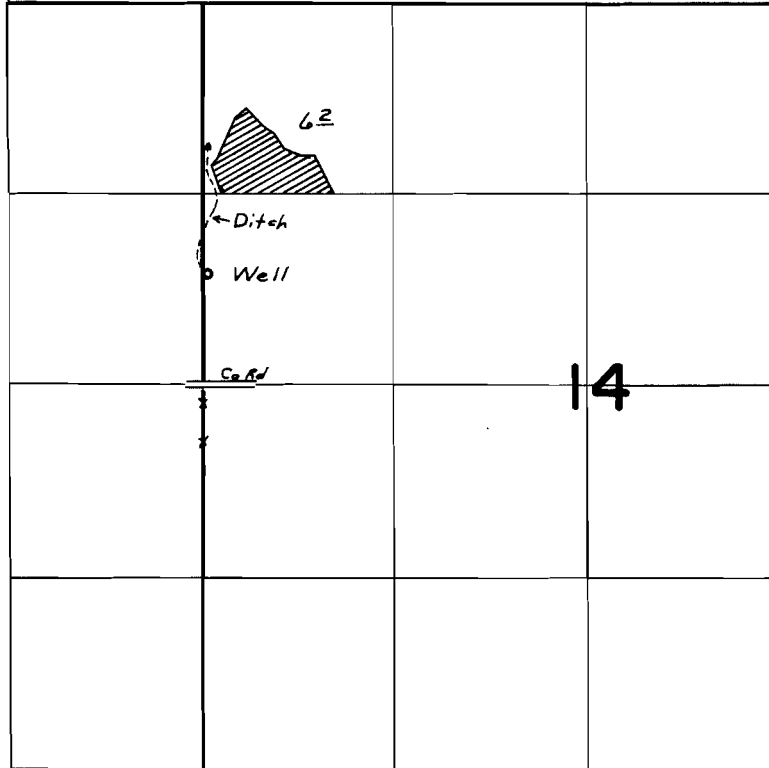

Well located 750 ft N + 30' E from W 1/4 Cor Sec 14

**FINAL PROOF SURVEY**  
UNDER

Application No. G-2964 Permit No. G-2772  
IN NAME OF

.....Dewey Ward.....

Surveyed Nov. 1 1967, by W. J. Ruppert