


T. 21 S. R. 46 E. W.M.

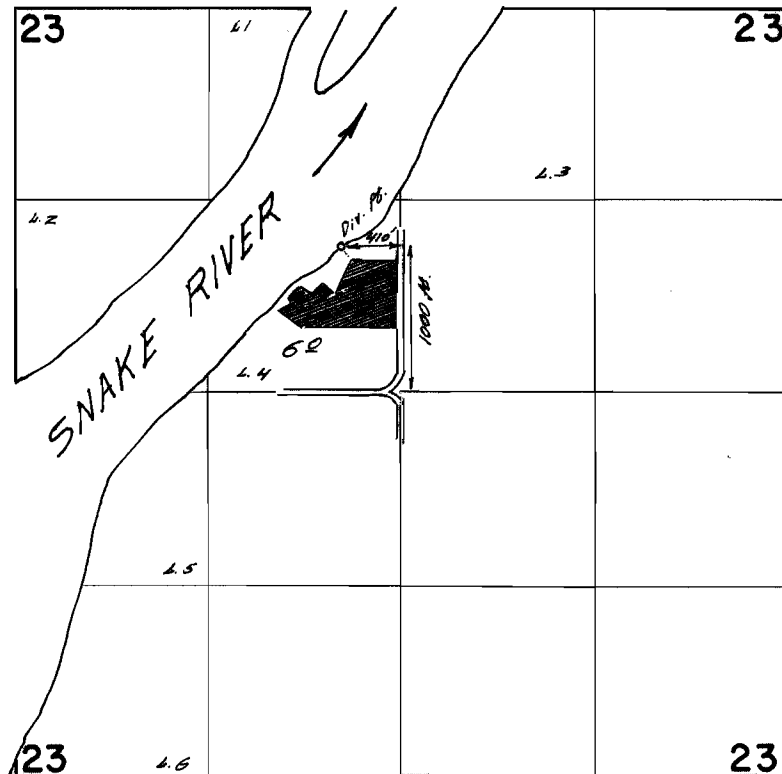

FINAL PROOF SURVEY
UNDER

Application No. 39234 Permit No. 29233
IN NAME OF

Cecil Smith

Surveyed Nov. 2 1967, by W. J. Ruppert