


T.18 S. R. 47 E. W.M.

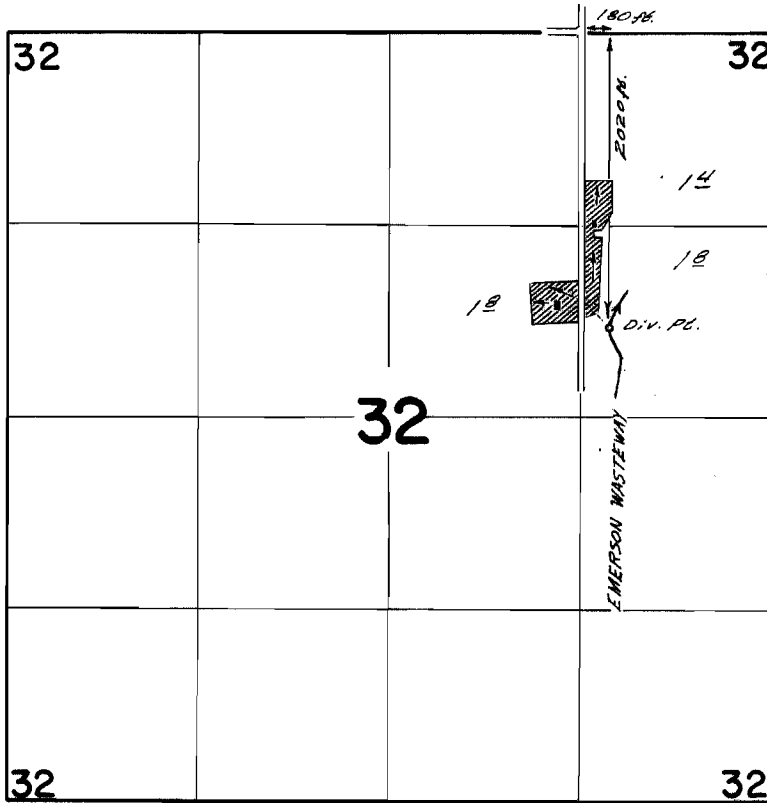

FINAL PROOF SURVEY UNDER

Application No. 39713 Permit No. 29546
IN NAME OF

Clarence E. Rees

Surveyed Nov. 2 1967, by W. d. Ruppert