


T.6S.R.2W.W.M.

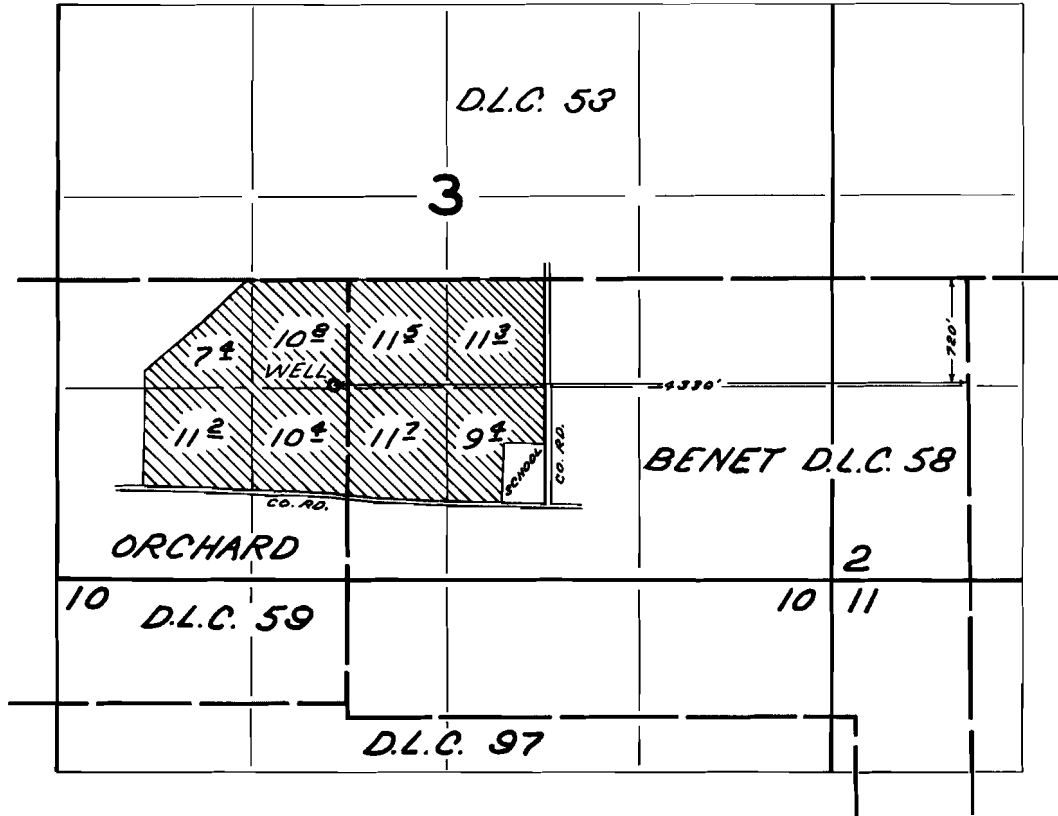

FINAL PROOF SURVEY
UNDER

Application No. G-2140 Permit No. G-1976
IN NAME OF

JAMES HOLLIN

Surveyed Nov. 27, 1967, by W. J. RUPPERT