


T.9S.R.1W.W.M.

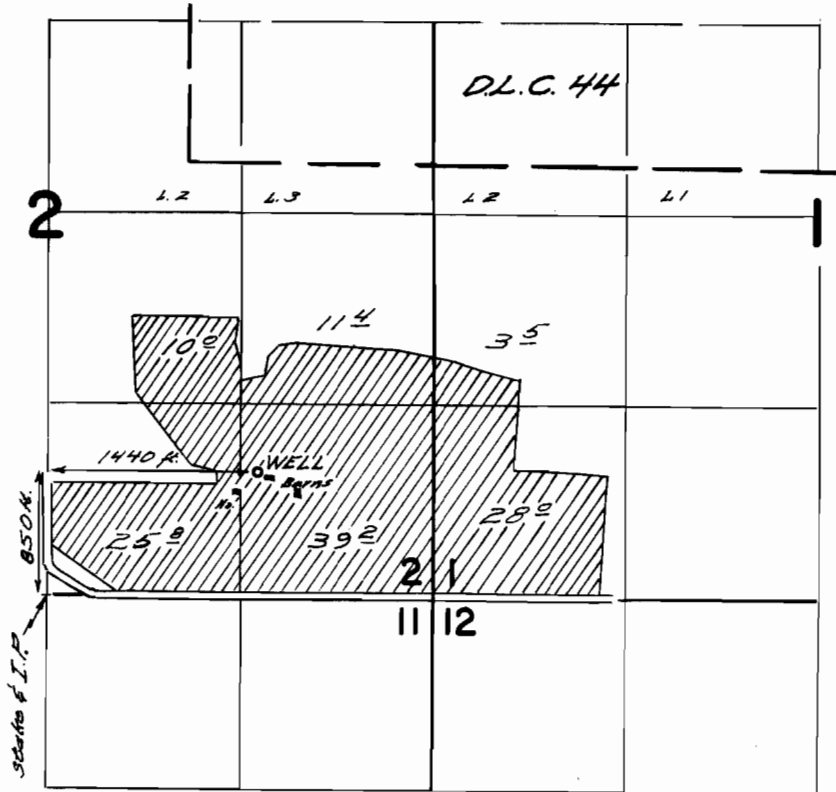

FINAL PROOF SURVEY UNDER

Application No. G-2321 Permit No. G-2147
IN NAME OF

Etzel Brothers

Surveyed Sept. 18, 1967, by W. J. Ruppert