


T. 4 S. R. 2 W. W. M.

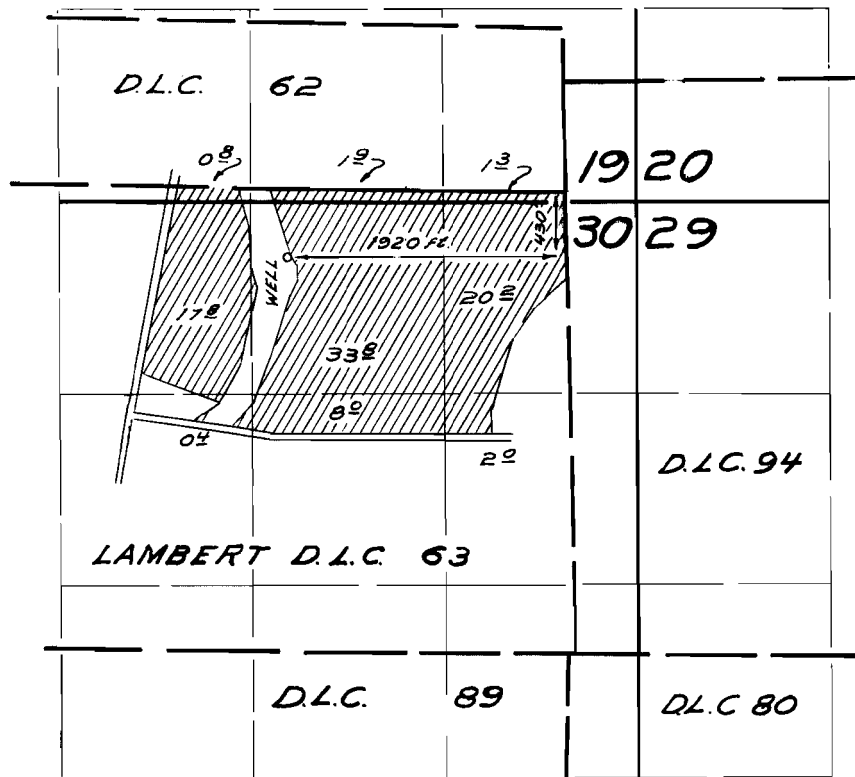

FINAL PROOF SURVEY UNDER

Application No. G-2751 Permit No. G-2556
IN NAME OF

MAURICE H. MERTEN

Surveyed April 6, 1967, by W. J. Ruppert