


T. 4 S. R. 2 W. W.M.

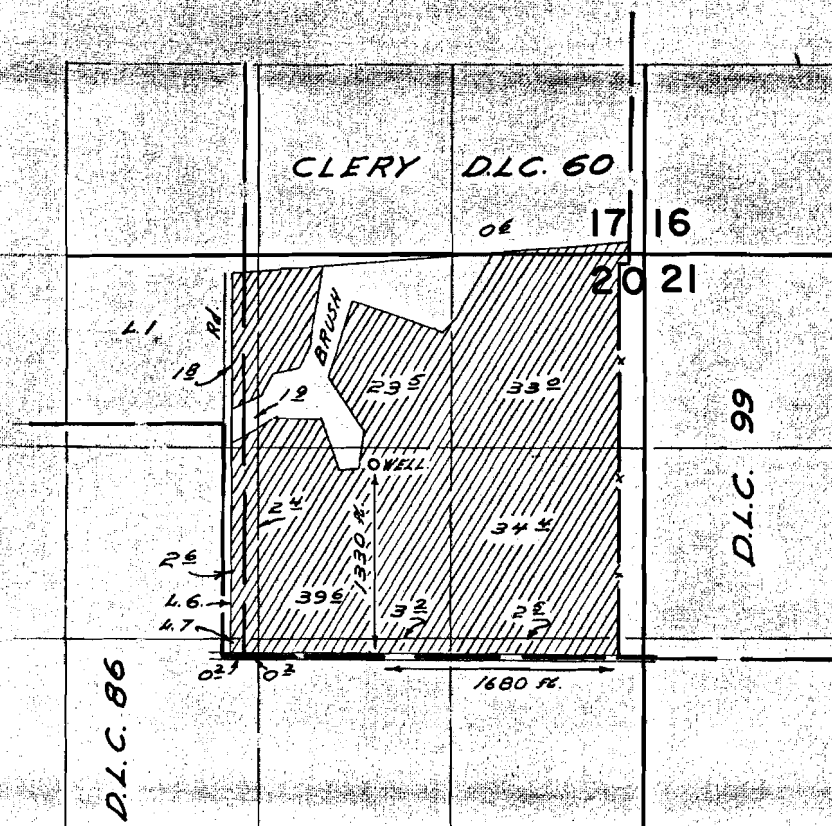

FINAL PROOF SURVEY
UNDER

Application No. G-2810 Permit No. G-2610
IN NAME OF

ELMER GOODING

Surveyed April 11, 1967, by W.J. Ruppert