


T.6S.R.3W.W.M.

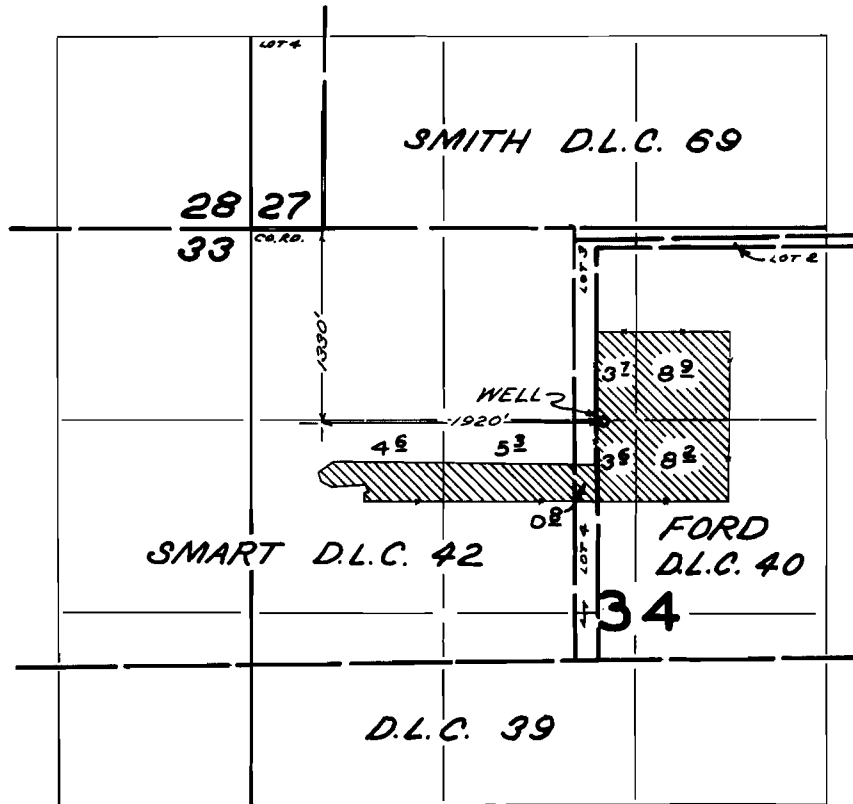

**FINAL PROOF SURVEY**  
UNDER

Application No. G-2830 Permit No. G-2646  
IN NAME OF

HENRY SCHMIDT

Surveyed Nov. 21, 1967, by W.J. RUPPERT