


# T.9S.R.IE.W.M.

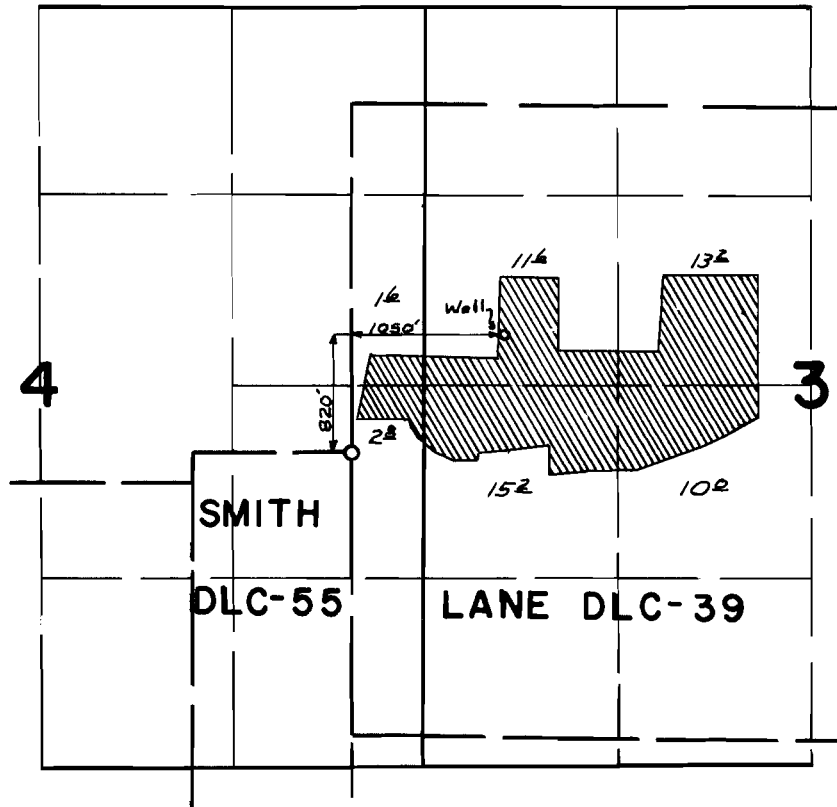

## FINAL PROOF SURVEY UNDER

Application No. *G-2876* Permit No. *G-2668*  
IN NAME OF

*Etzel Brothers*

Surveyed *Aug. 11* 19*67*, by *W. J. Ruppert*