


T.6S.R.3W.W.M.

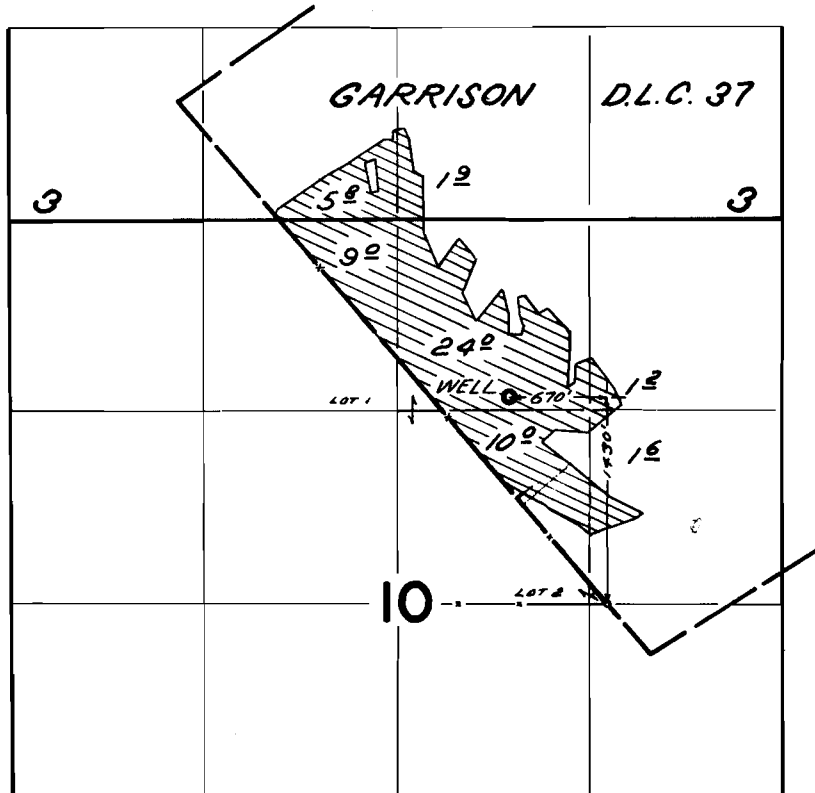

FINAL PROOF SURVEY UNDER

Application No. G-2896 Permit No. G-2680
IN NAME OF

PAUL TOWNSEND

Surveyed Nov. 20 & 21, 1967, by W. J. RUPPERT