


T.6S.R.1W.W.M.

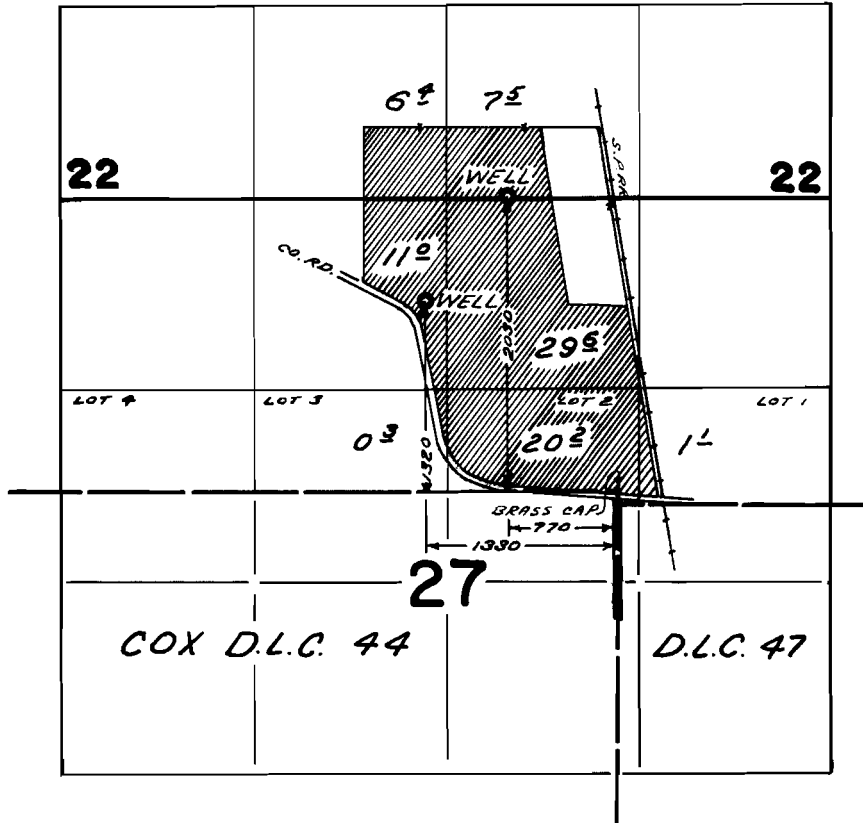

FINAL PROOF SURVEY UNDER

Application No. G-2977 Permit No. G-2765
IN NAME OF

JOHN S. GERLITS

Surveyed APR. 24 1968, by L. GOULD