


T.6S.R.2W.W.M.

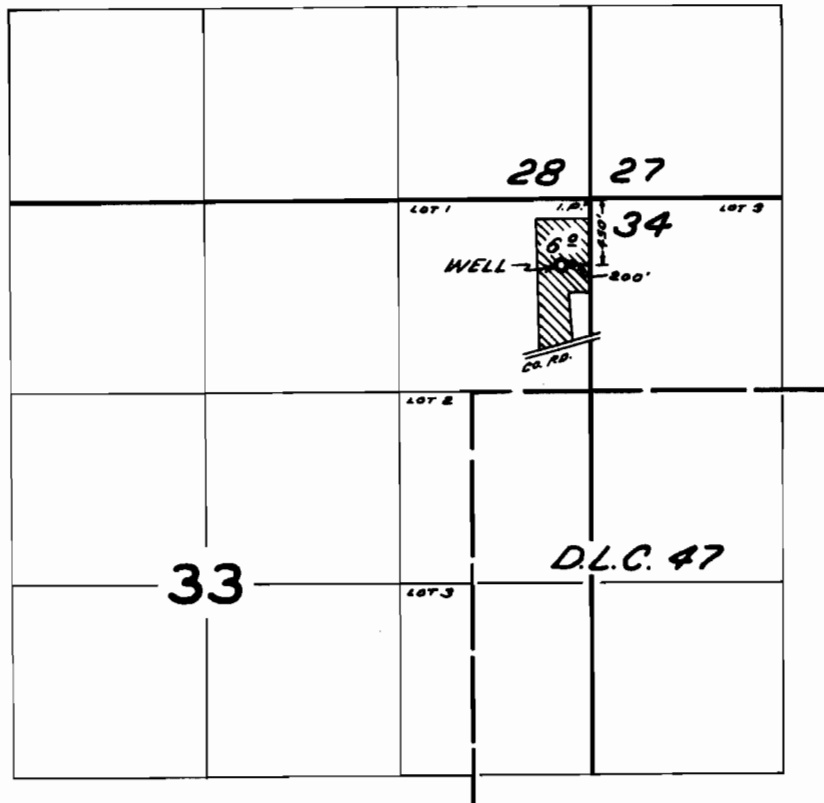

FINAL PROOF SURVEY
UNDER

Application No. G-3110 Permit No. G-2905
IN NAME OF

DALE HERIGSTAD

Surveyed Nov. 28 1967, by W. J. RUPPERT