


T.6S.R.2W.W.M.

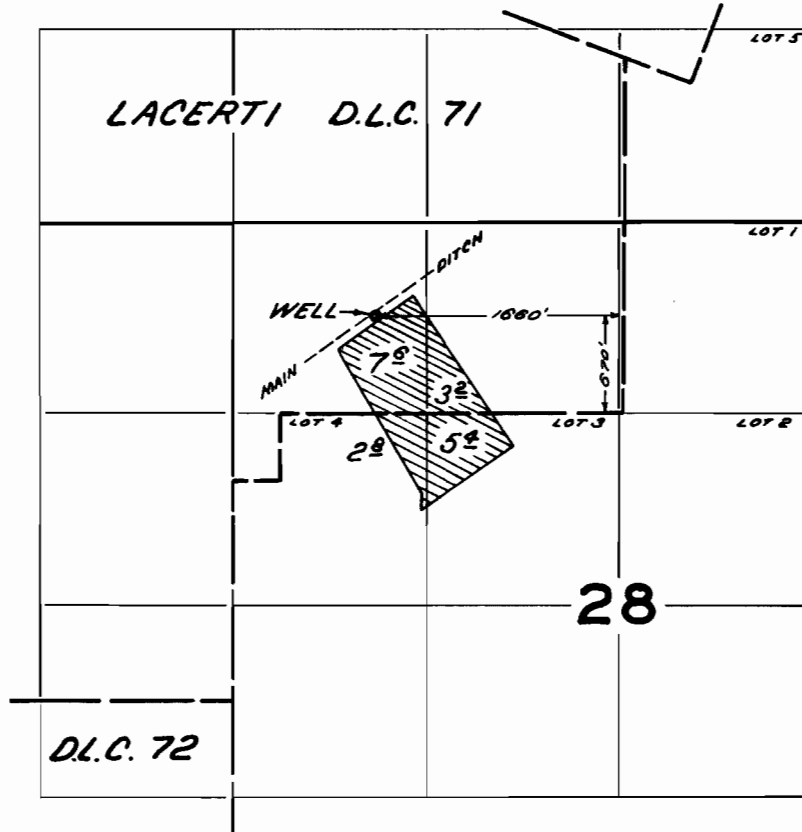

FINAL PROOF SURVEY  
UNDER

Application No. G-3253 Permit No. G-3050  
IN NAME OF

TATSURO YADA

Surveyed Nov. 28, 1967, by W. J. RUPPERT