


T. 4 S. R. 18 & 2 W. W. M

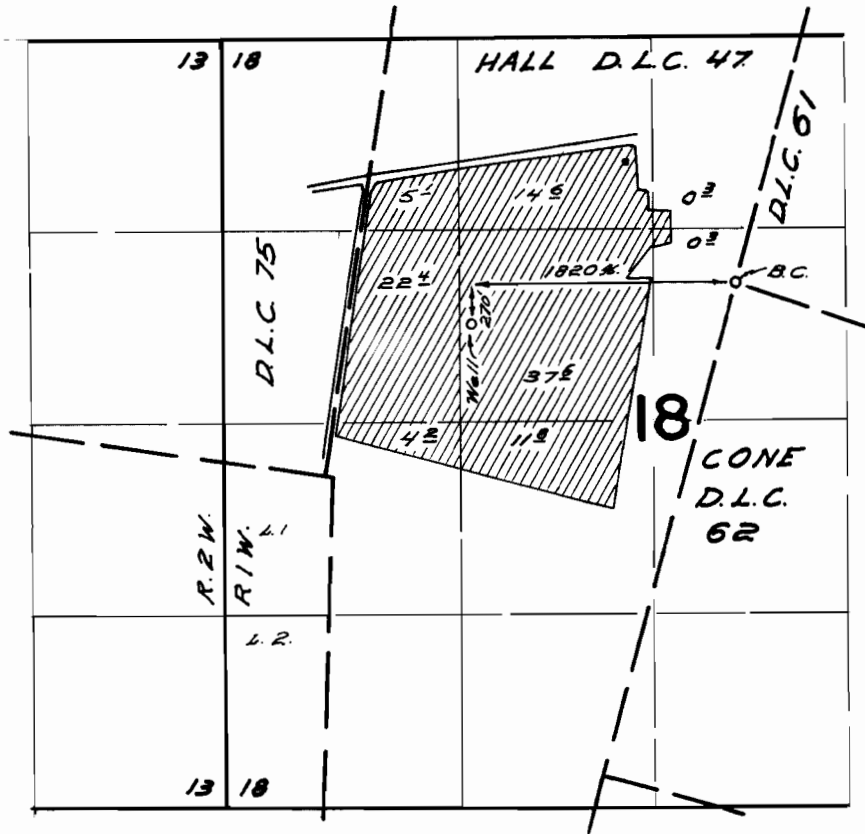

FINAL PROOF SURVEY UNDER

Application No. G-3352 Permit No. G-3146
IN NAME OF

Francis X. Ryan

Surveyed May 4 1967, by W. J. Ruppert