


T.6S.R.3W.W.M.

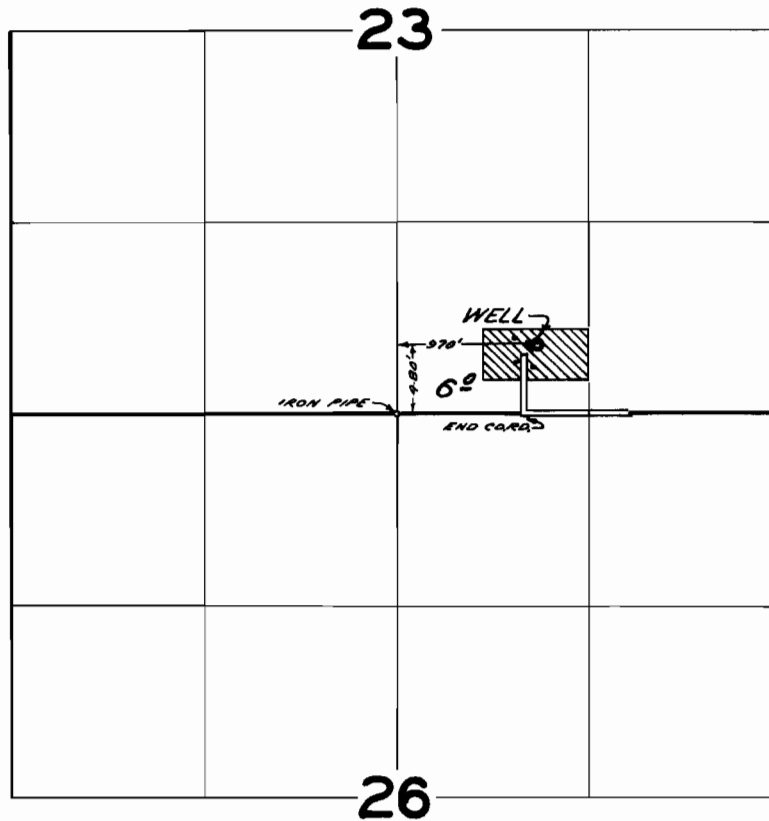

FINAL PROOF SURVEY
UNDER

Application No. G-3403 Permit No. G-3193
IN NAME OF

GLENN W. ROLOFSON

Surveyed Nov. 21, 1967, by W. J. RUPPERT