


T.6S.R.2W.W.M.

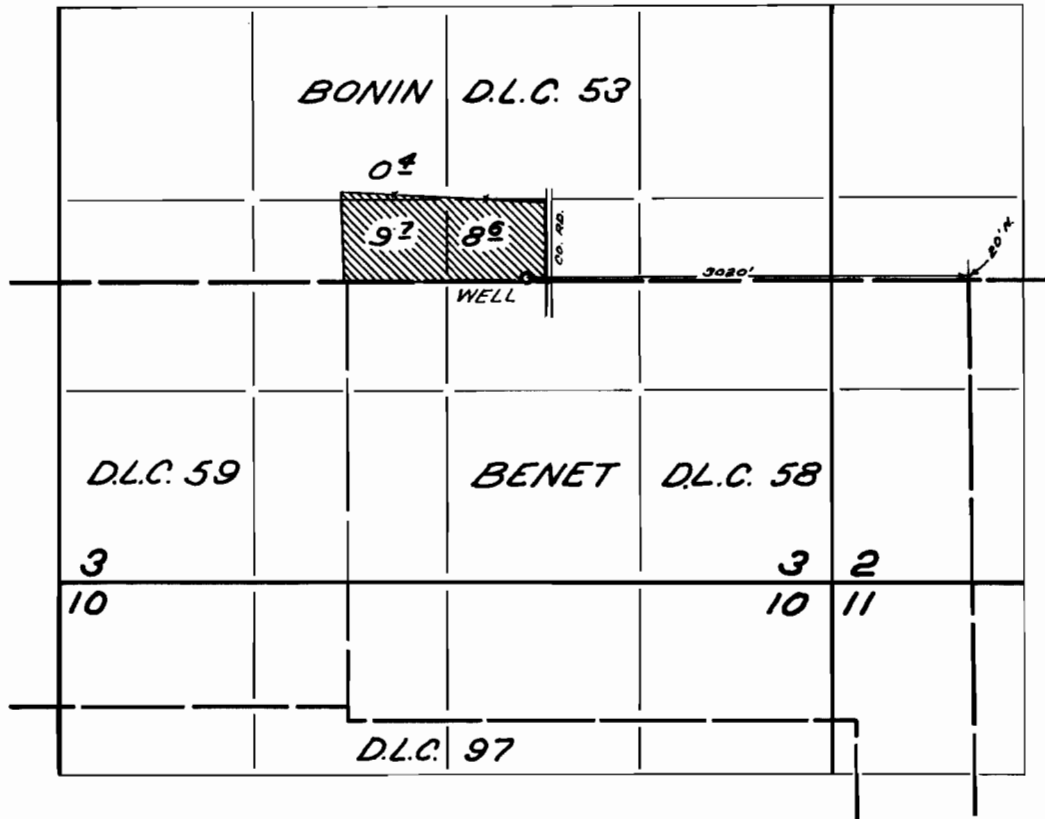

FINAL PROOF SURVEY
UNDER

Application No. G-3426 Permit No. G-3212
IN NAME OF

HENRY F. CAUGHLIN

Surveyed Nov. 27, 1967, by W.J. RUPPERT