
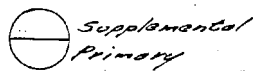


T.7&8S.R.1W.W.M.

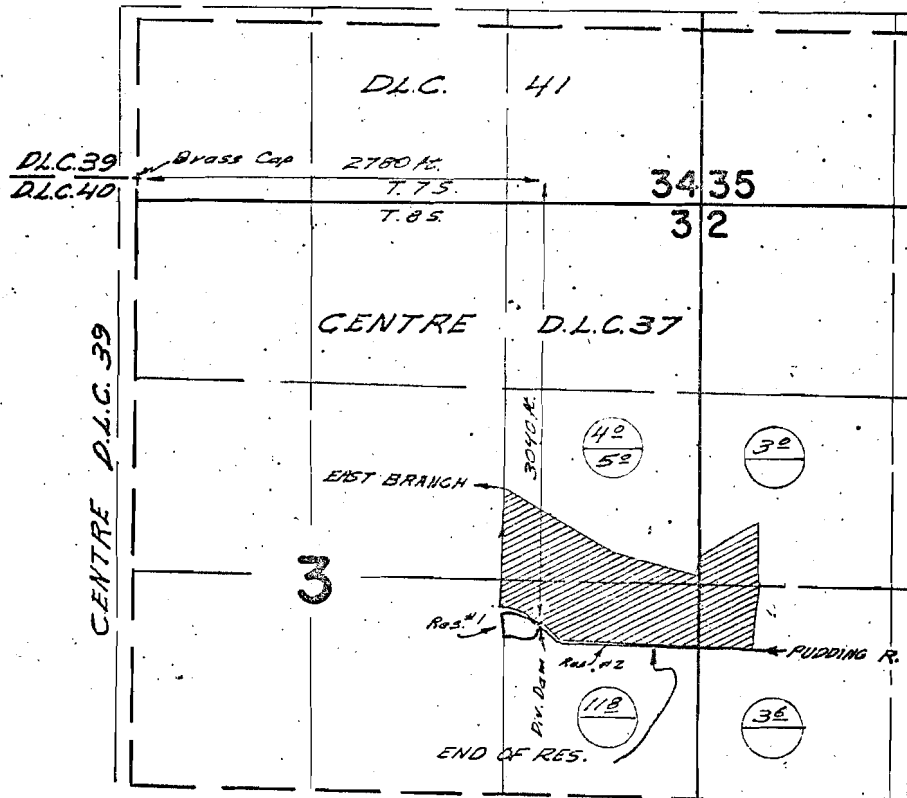

FINAL PROOF SURVEY
UNDER

R-37313

R-2721

Application No. 37314 Permit No. 27796
IN NAME OF

David Doertler

Surveyed Sept. 19 1967, by H. J. Ruppert