


T. 4 S. R. 2 W. W.M.

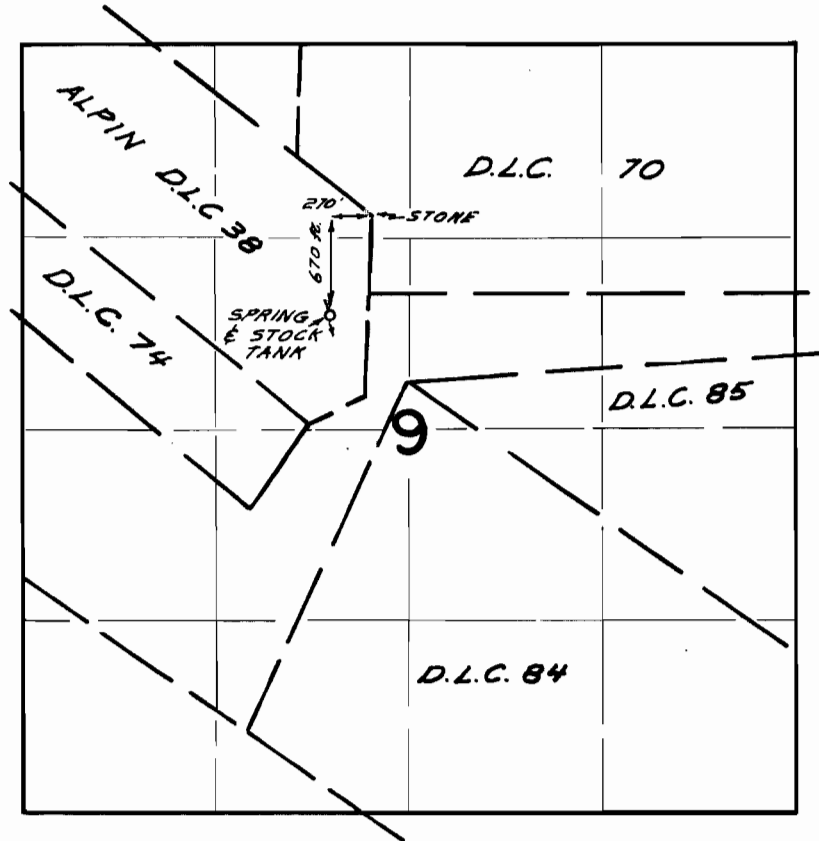

FINAL PROOF SURVEY
UNDER

Application No. 38907 Permit No. 29087
IN NAME OF

Mildred Mae Anderson

Surveyed May 5 1967, by W.J. Ruppel