


T.9S.R.2E.W.M.

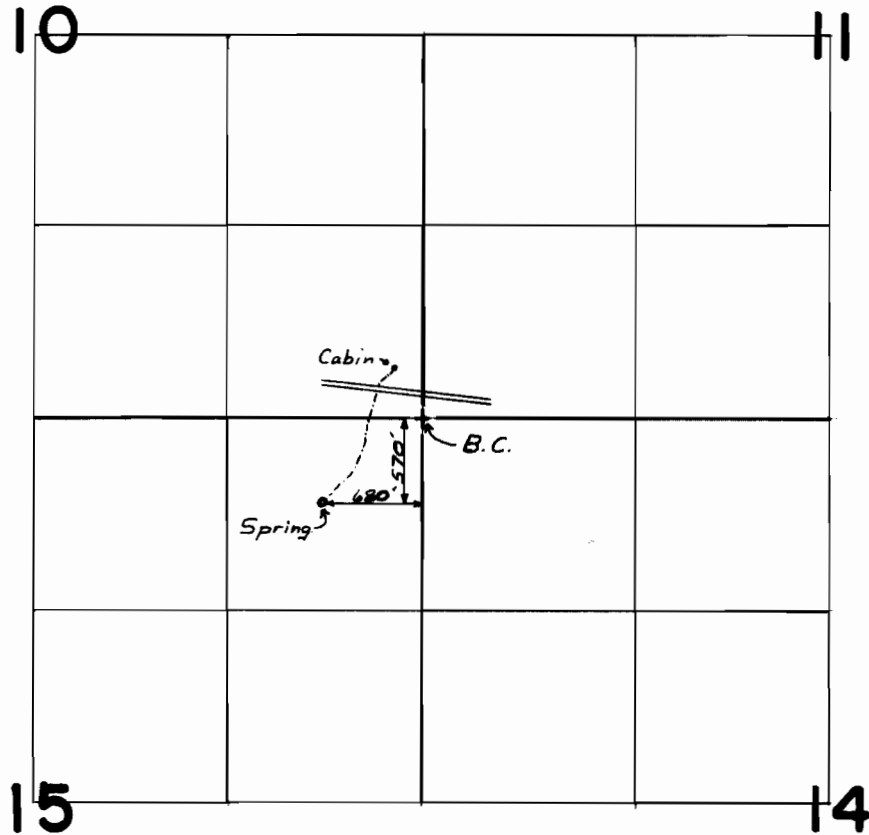

FINAL PROOF SURVEY UNDER

Application No. *39067* Permit No. *29168*
IN NAME OF

GUSTAVE A. & EFFIE A. OSTRIK

Surveyed *Aug. 9* 19*67*, by *W. C. Ruppert*.