


T. 3 & 4 S. R. 2 W. W. M

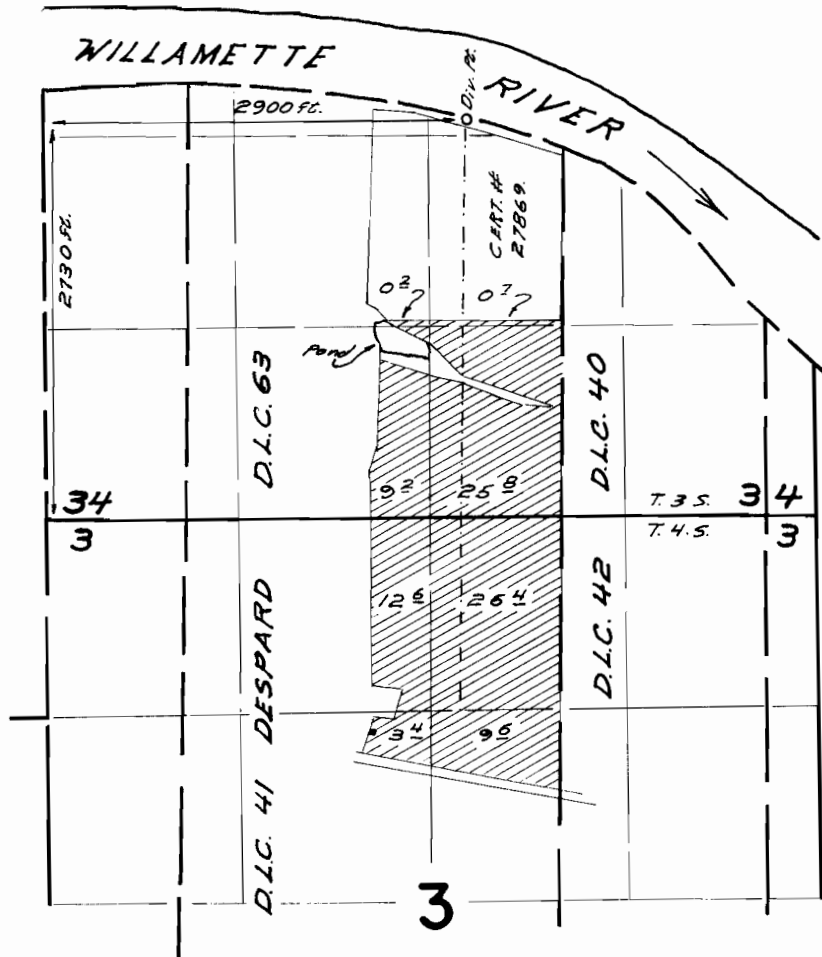

FINAL PROOF SURVEY UNDER

Application No. 39311 Permit No. 29276
IN NAME OF

Frank Abderhalden

Surveyed May 2, 1967, by W.J. Ruppert