


T. 4 & 5 S. R. 2 & 3 W. W. M

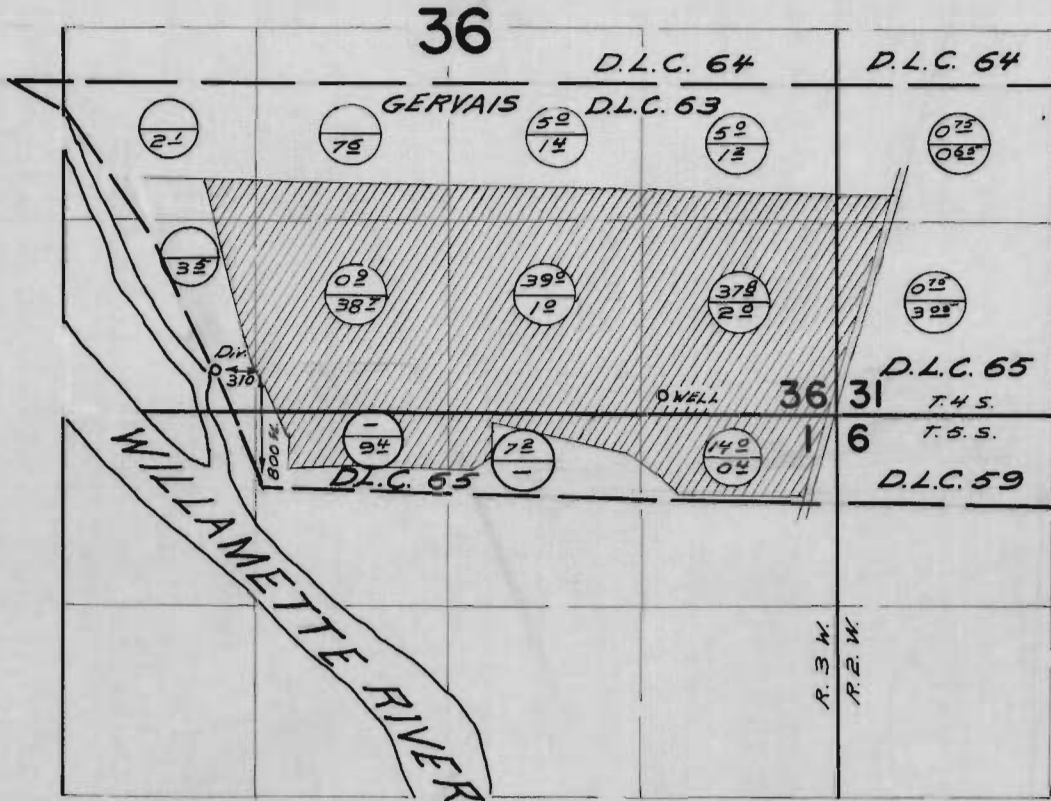

⊕ - SUPPLEMENTAL TO CERT. GR. 3044
○ - PRIMARY

FINAL PROOF SURVEY
UNDER

Application No. 42132 Permit No. 31543
IN NAME OF

LEONA NEVITT

Surveyed April 6, 1967, by W. d. Ruppert