


T.6S.R.3W.W.M.

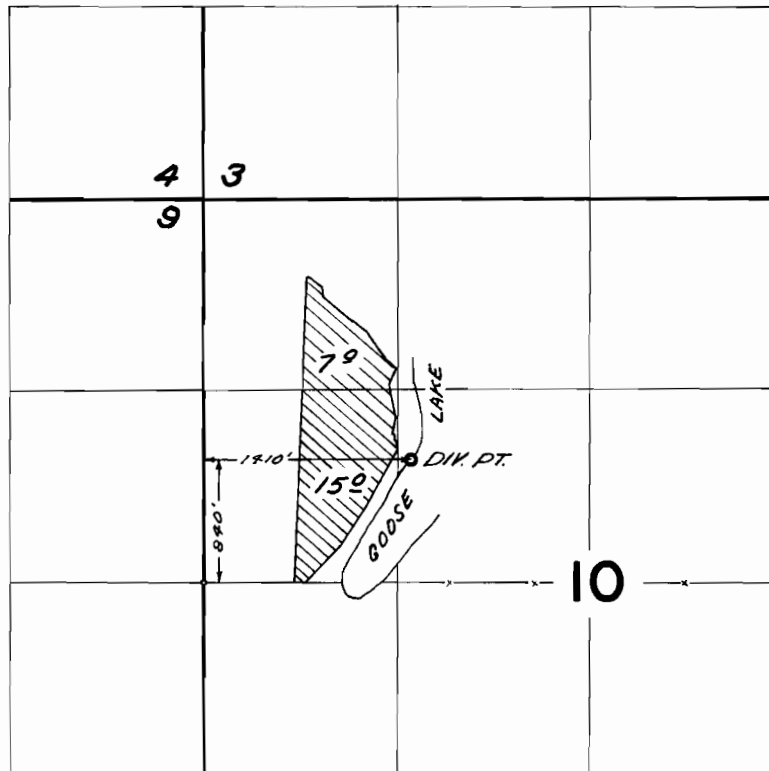

FINAL PROOF SURVEY
UNDER

Application No. 42833 Permit No. 32014
IN NAME OF

EMMA V. SEELY

Surveyed Nov. 20 1967, by W. J. RUPPERT