


# T. 1 N. R. 26 E. W. M.

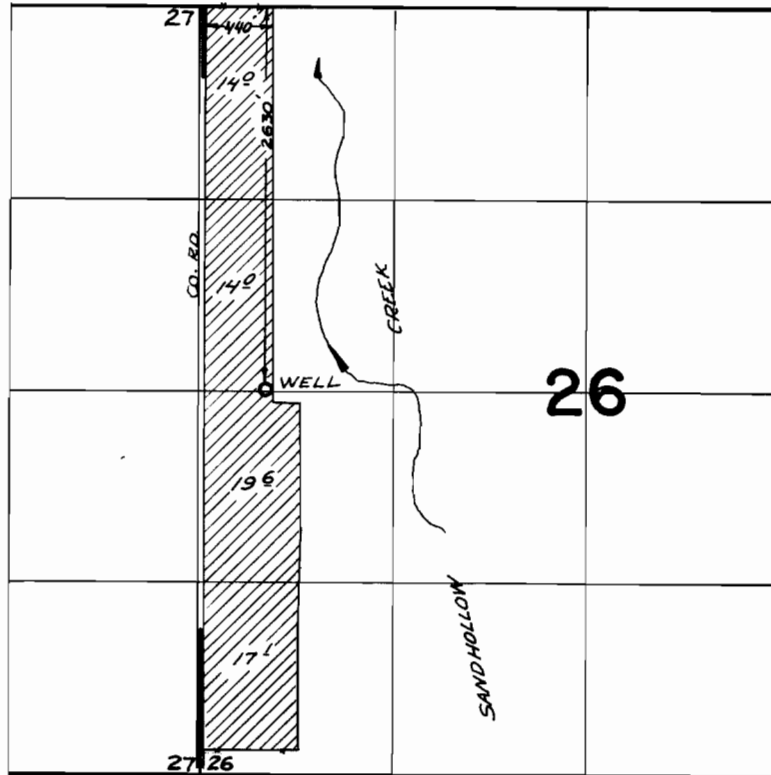

## FINAL PROOF SURVEY UNDER

Application No. G-2605.. Permit No. G-2409.  
IN NAME OF

*KENNETH TURNER*

Surveyed *June 21, 1967.*, by *L.E. Gould*.....