


29165
R-3874

T.2N.R.15E.W.M.

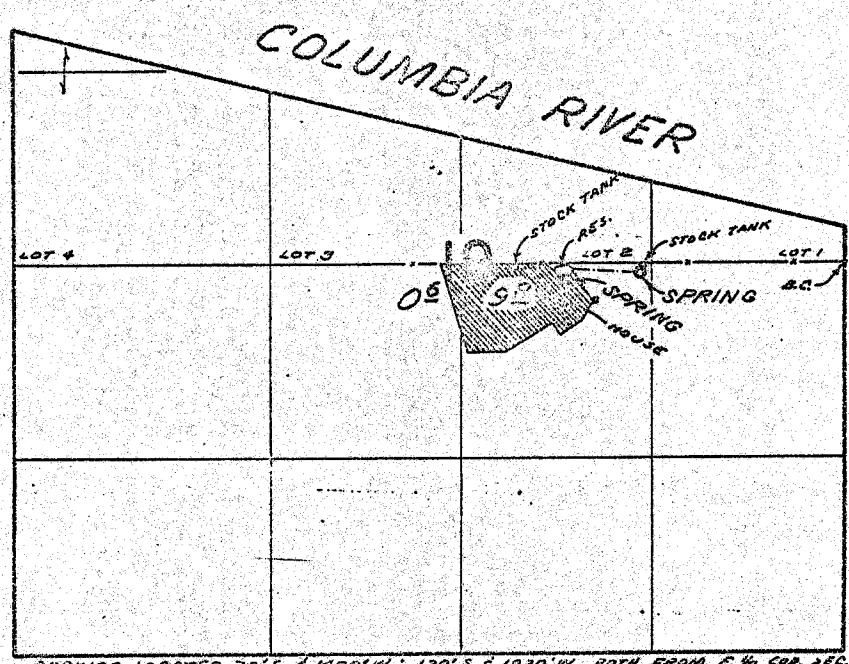

FINAL PROOF SURVEY
UNDER

Application No. 38967 Permit No. 29165
R-39127 R-3874
IN NAME OF

MR. AND MRS. LOYD MESSINGER

Surveyed Nov. 8 1967, by W. J. RUPPERT