


T.1N. R.13E. W.M.

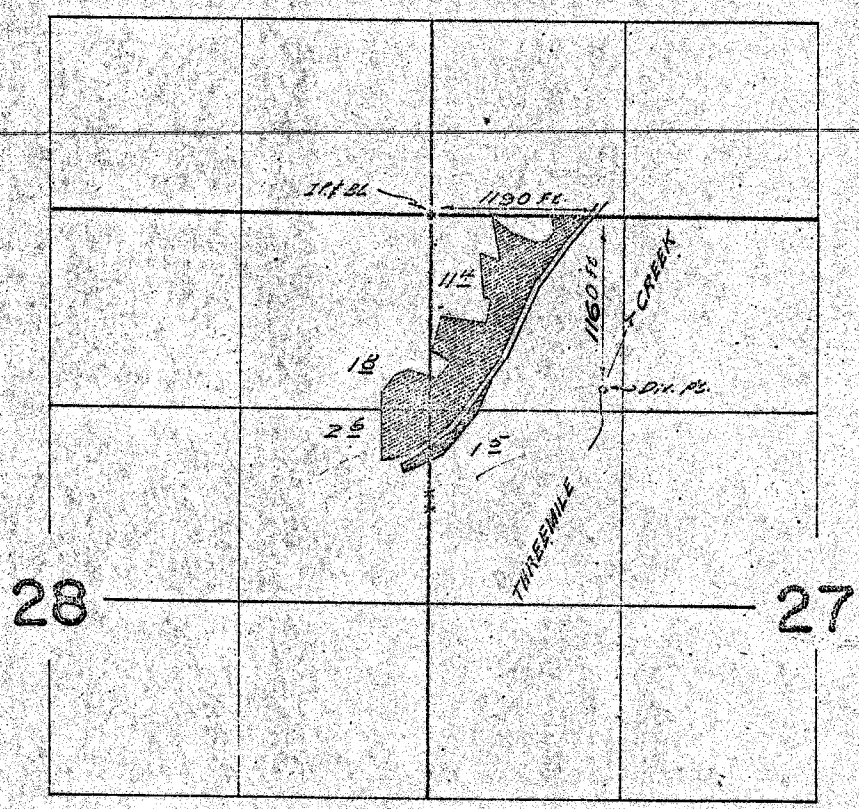

FINAL PROOF SURVEY  
UNDER

Application No. 32834 Permit No. 29656  
IN NAME OF

*Ernest L. Morast*

Surveyed July 19, 1967, by *W. J. Ruppert*