


29852

T. 2 N. R. 11 & 12 E. W. M.

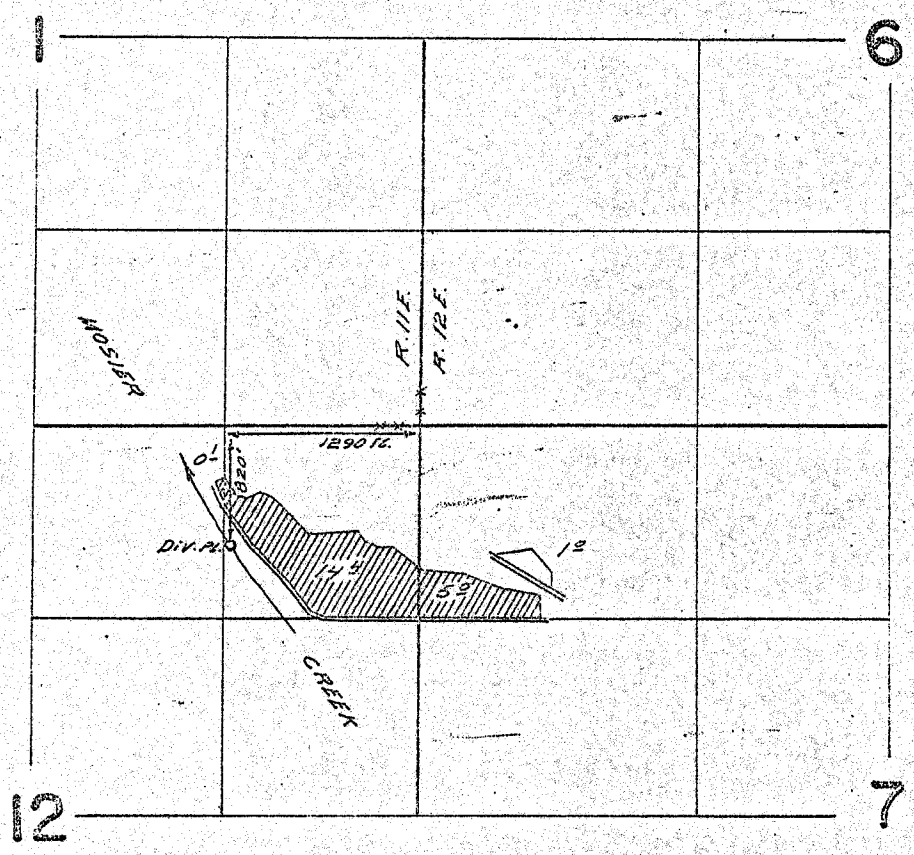

FINAL PROOF SURVEY
 UNDER

Application No. *40044* Permit No. *29852*
 IN NAME OF

Marvil B. & Virginia Troxel

Surveyed *July 21, 1967*, by *W. J. Ruppert*

1150