


T. 2S. R. 12E. W.M.

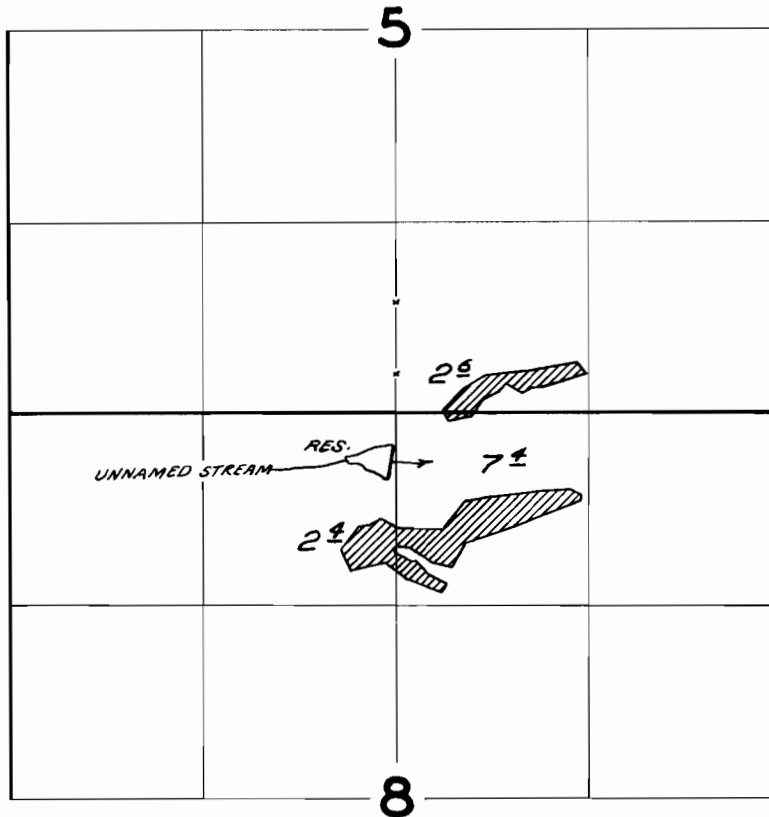

DIV. PT. LOCATED 340 FT. S. AND 30 FT. W. FROM N. 1/4 COR. SEC. 8

FINAL PROOF SURVEY
UNDER

Application No. R-42366 42367 Permit No. R-4805 31694
IN NAME OF

FRANK R. GIBBS

Surveyed NOV 15 1967, by W.J. RUPPERT