


31753

T.2N.R.14E.W.M.

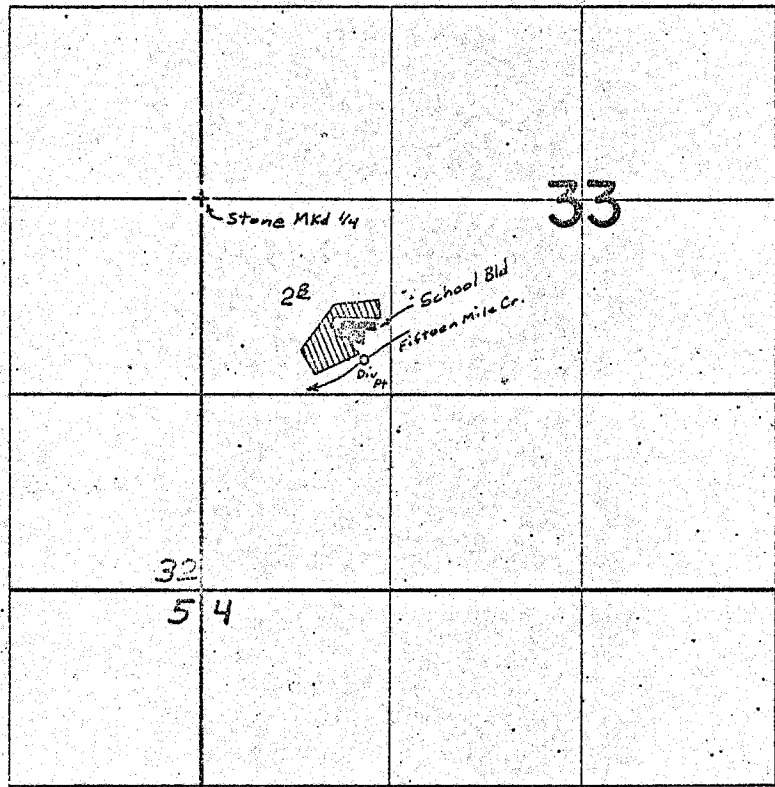

Div Pt. located 1080ft S & 1130ft E From W 1/4 Cor. of Sec 33

FINAL PROOF SURVEY UNDER

Application No. 42442... Permit No. 31753...
IN NAME OF

Petersburg Elementary School Dist. 14C

Surveyed June 13... 1967, by *W. d. Ruppert...*