


32239

T.1S.R.14E.W.M.

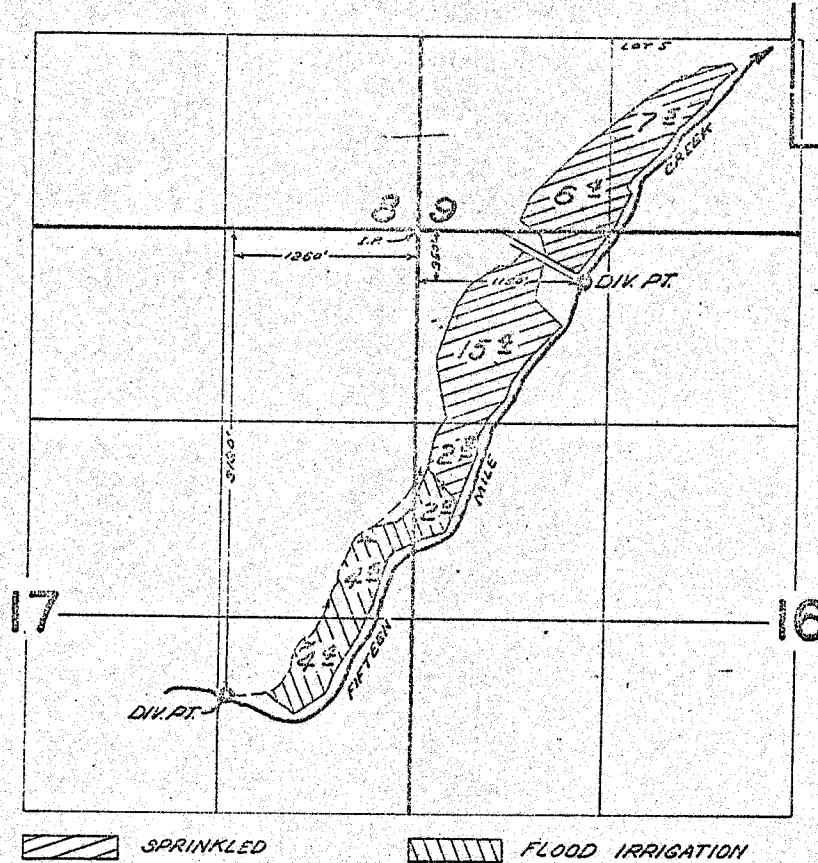

FINAL PROOF SURVEY
UNDER

Application No. 43159 Permit No. 32239
IN NAME OF

WILLIAM L. AND WILMA M. BOLTON

Surveyed Nov. 13, 1967, by W. J. RUPPERT