


# T.1N.R.3 W.W.M.

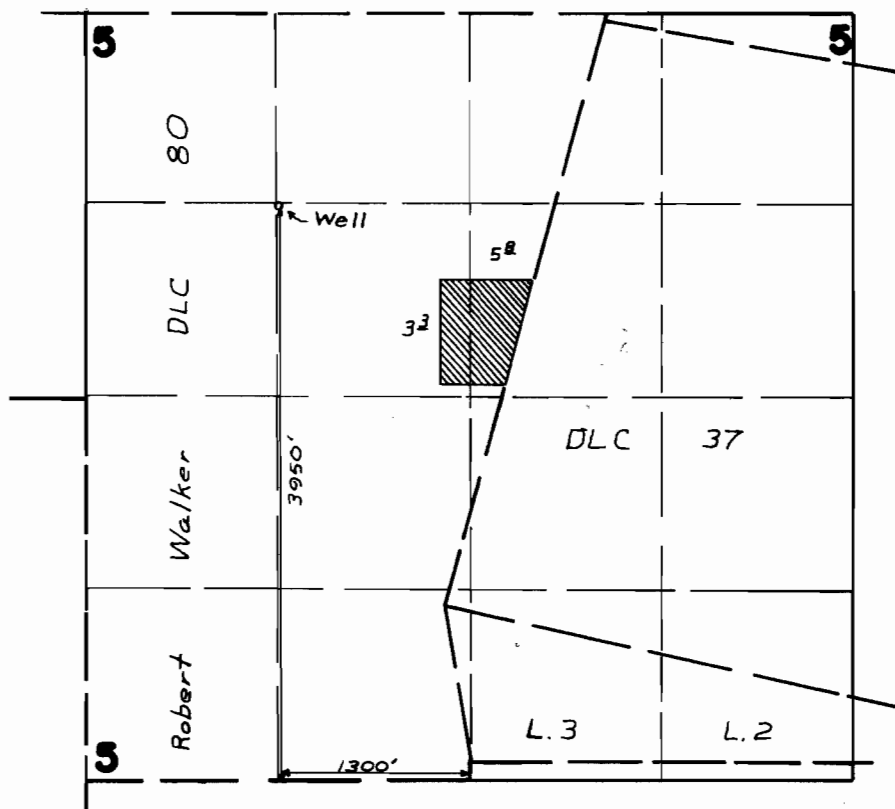

## FINAL PROOF SURVEY UNDER

Application No. G-3511..... Permit No. G-3305.  
IN NAME OF

*Myron F. and Elaine G. Duyck.....*

Surveyed *Aug. 14, 1967,* by *W. J. Ruppert*