


T.I.S.R.2 W.W.M.

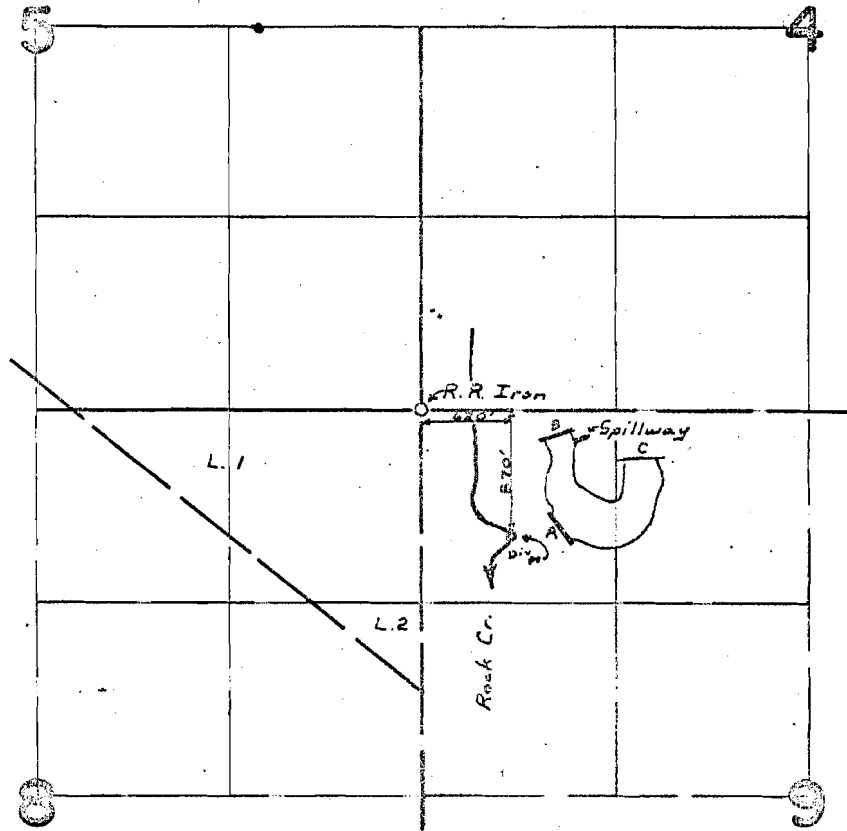

FINAL PROOF SURVEY UNDER

R-38776 R-3415
Application No. 38885... Permit No. 28954...
IN NAME OF

Valley Memorial Park, Inc.....

Surveyed Aug. 15, 1967, by W.J. Ruppert.....