


T. 2 S. R. 3 W. W. M.

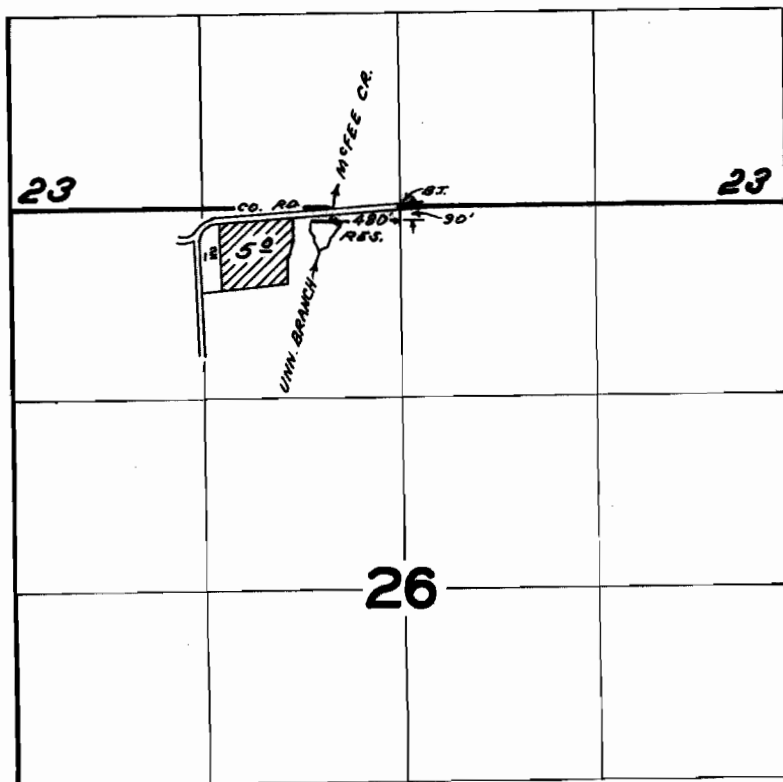

FINAL PROOF SURVEY
UNDER

Application No. R-34280 / 34281 Permit No. R-2470 / 26974
IN NAME OF

OTTO J. ORNDUFF

Surveyed AUG 10 1967, by V. GARNER