



T.7&8S. R.46E.W.M.

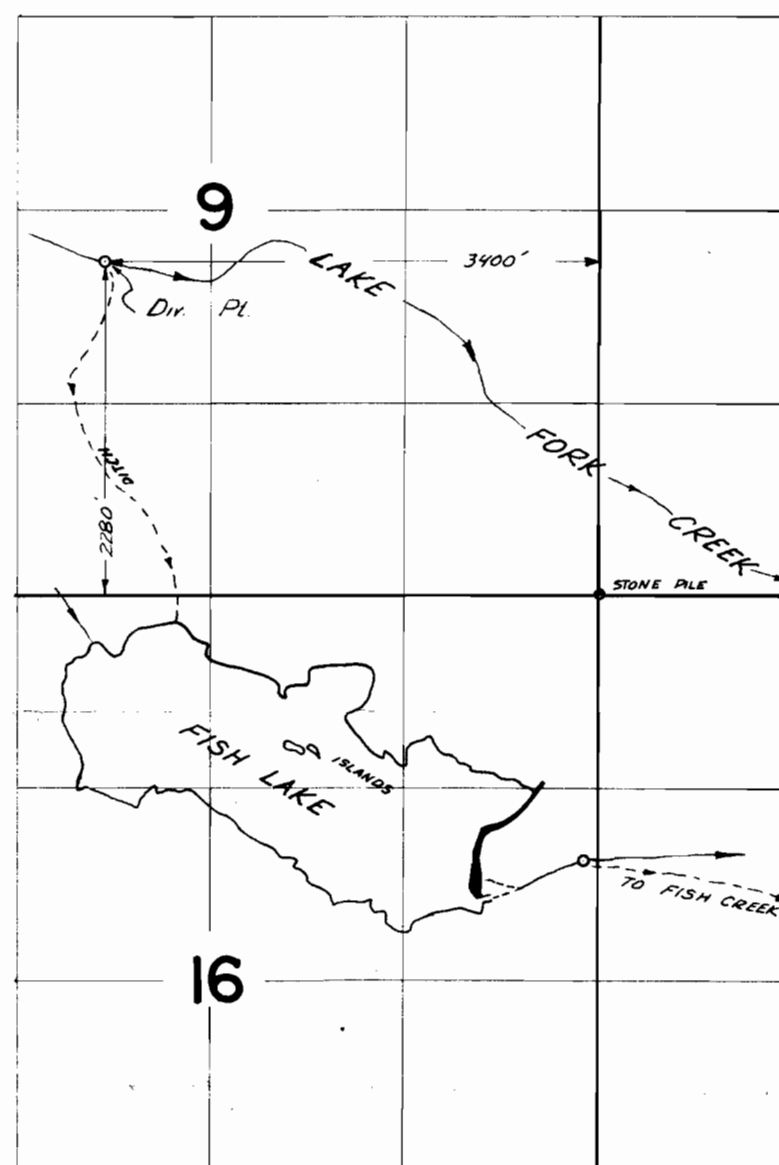

T.6S. R.46E.W.M.



T.7S. R.46E.W.M.


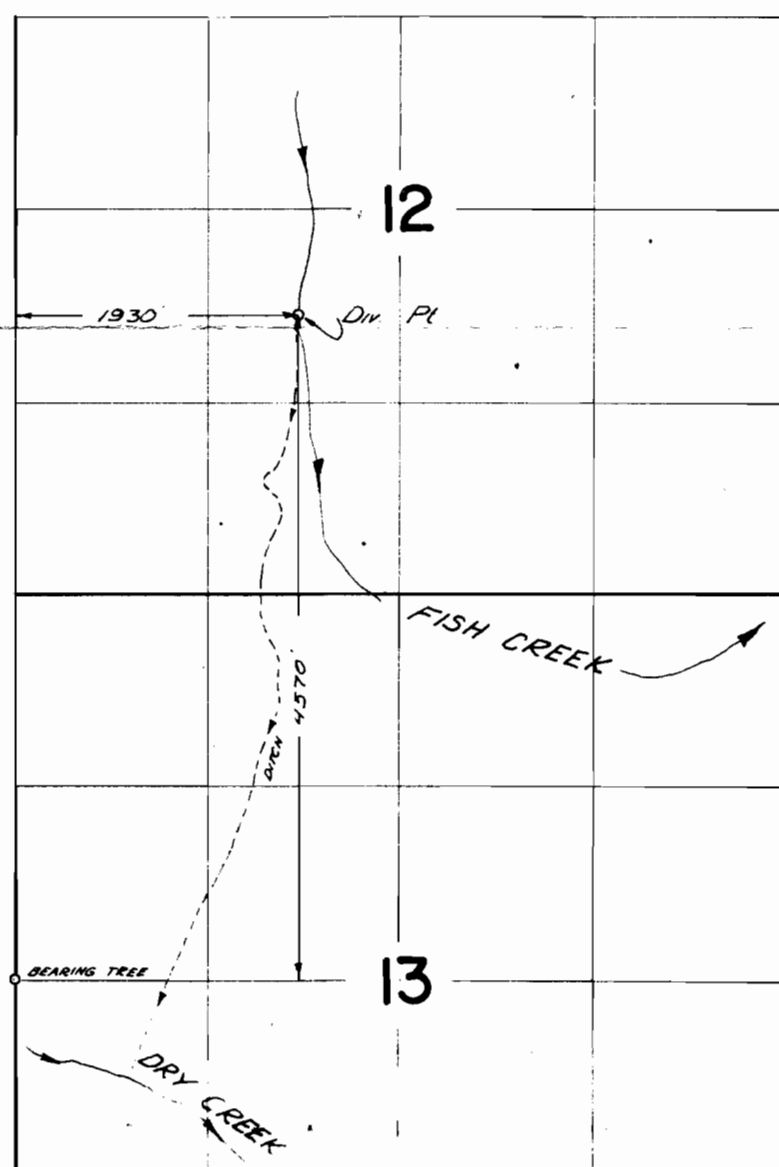


FINAL PROOF SURVEY

UNDER
Application nos. R 25508 Permit nos. R 1116
25631 20175

IN NAME OF
FISH LAKE IMPROVEMENT DISTRICT

Surveyed Aug. 1,2,3, 1967 by V. Garner

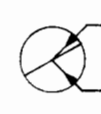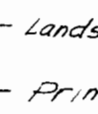 Lands for which prior rights exist - supplemental
 Primary irrigation