T.7&8S. R.46E.W.M.

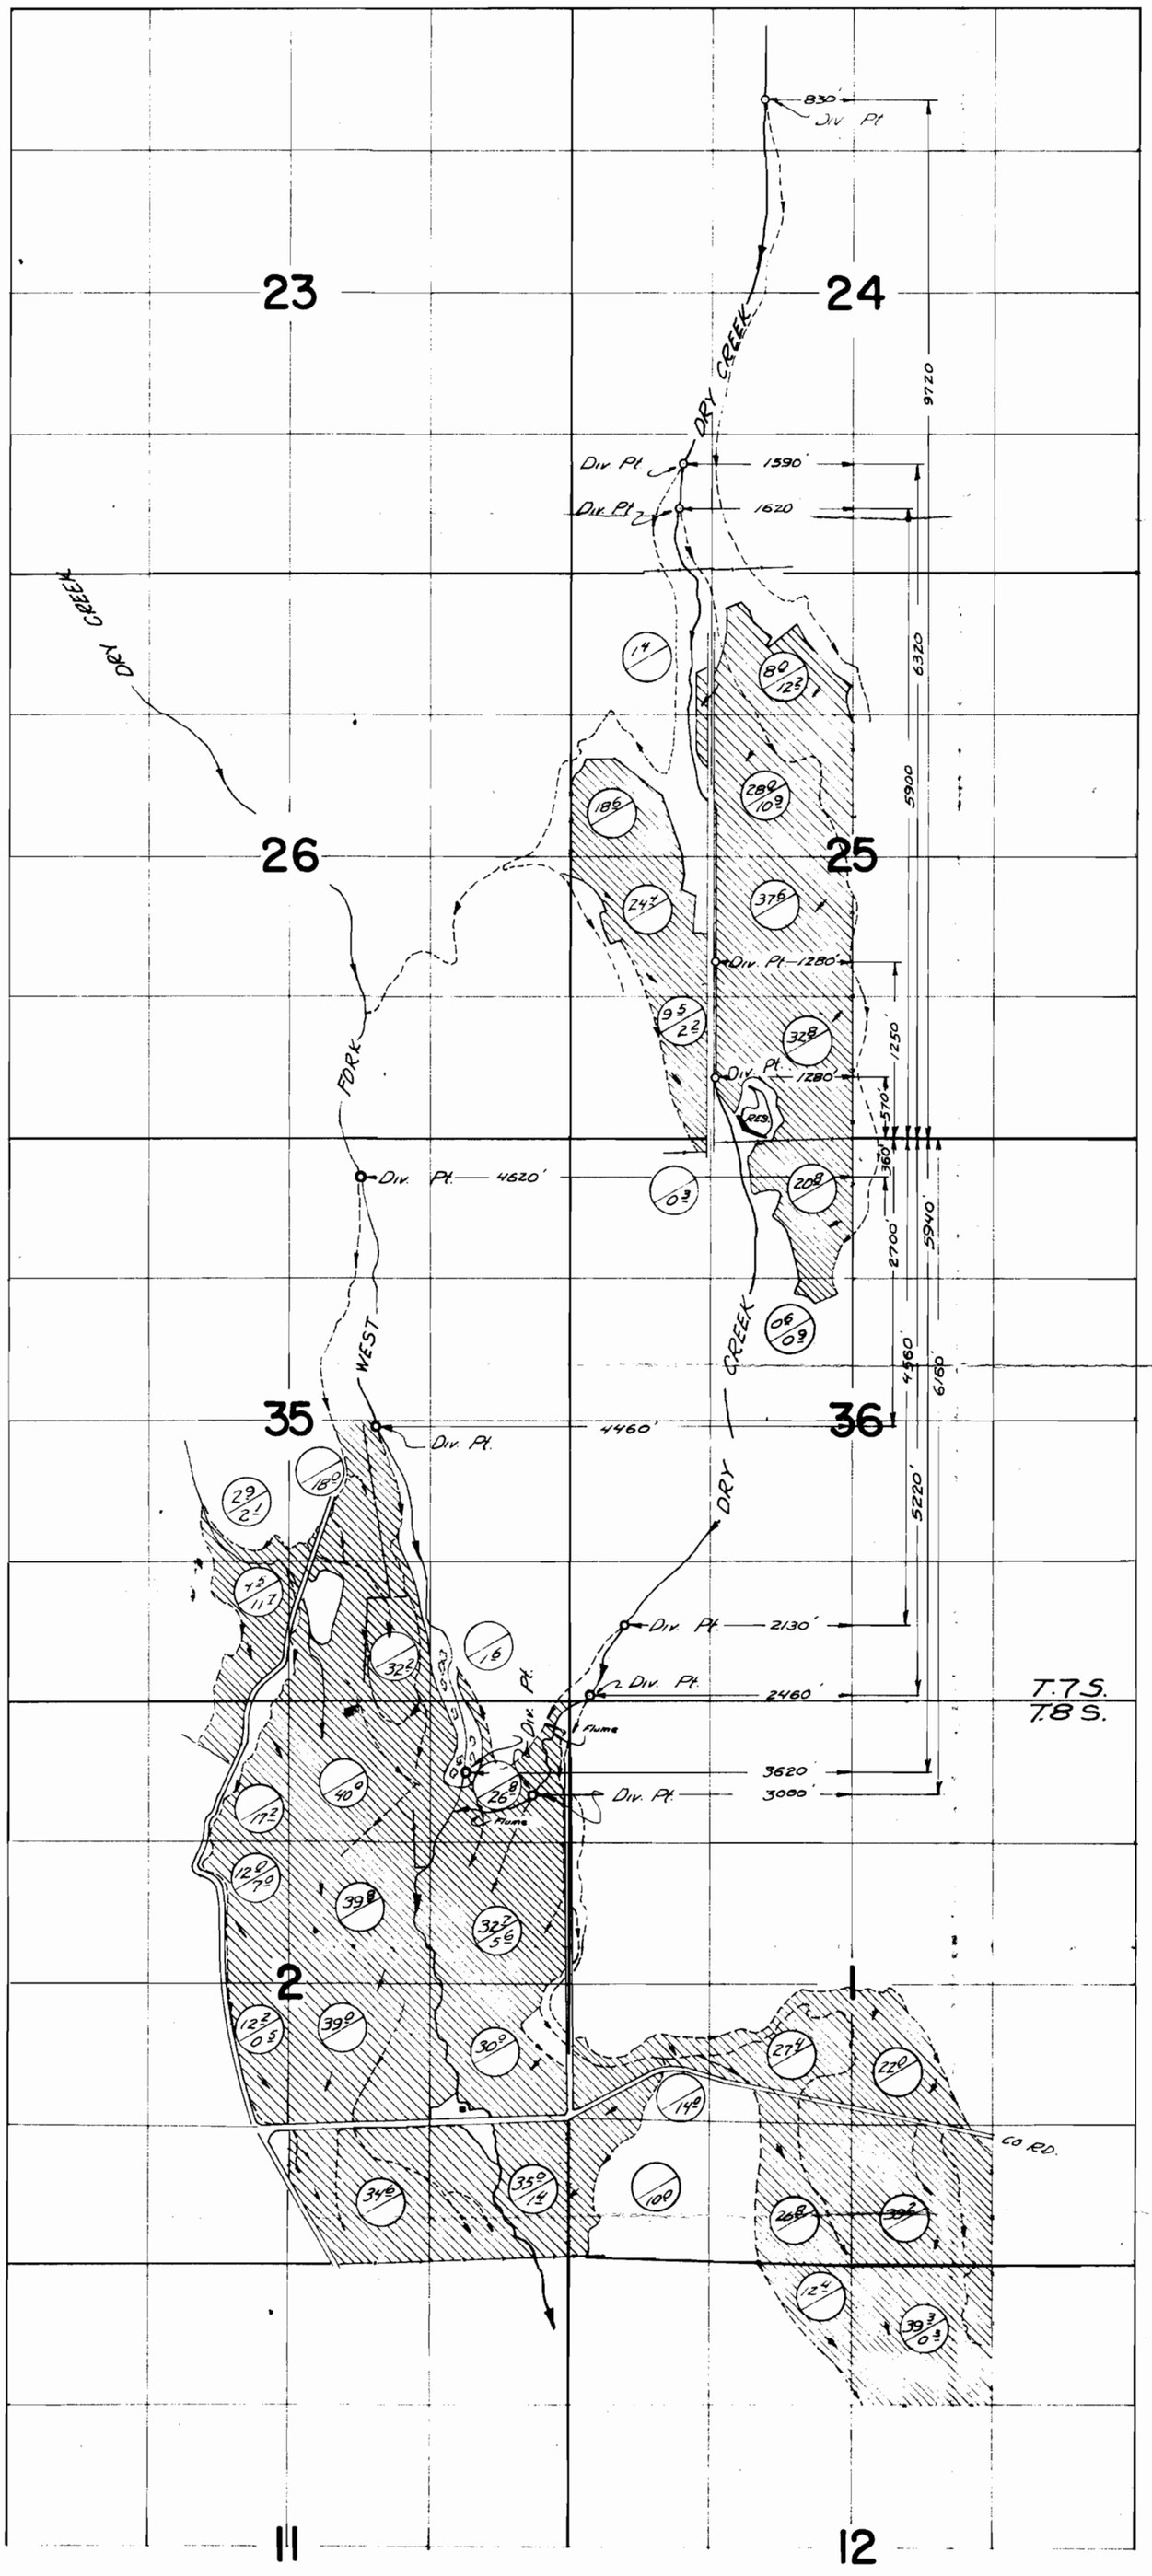

T.6S. R.46E.W.M.

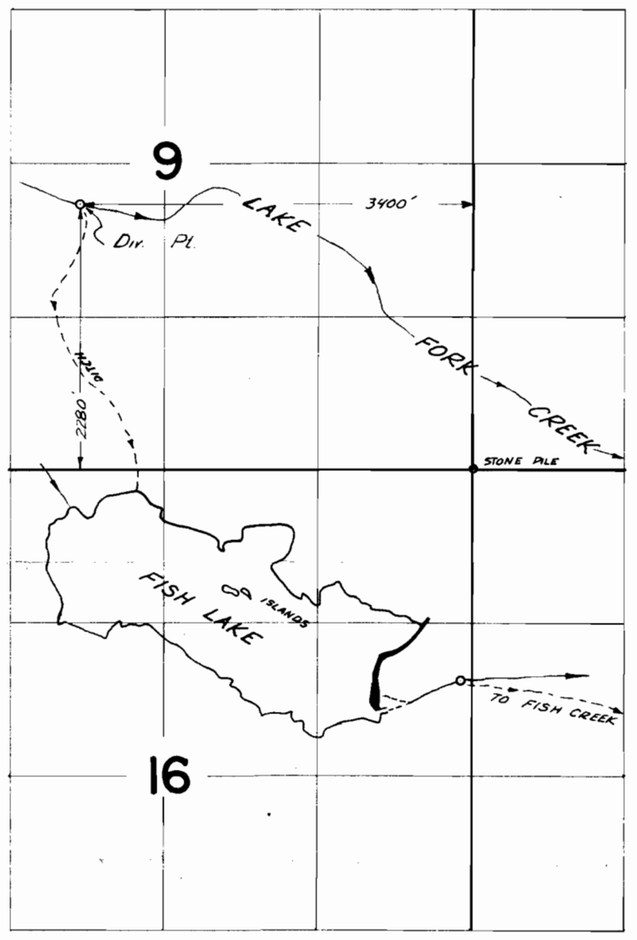

T.7S. R.46E.W.M.

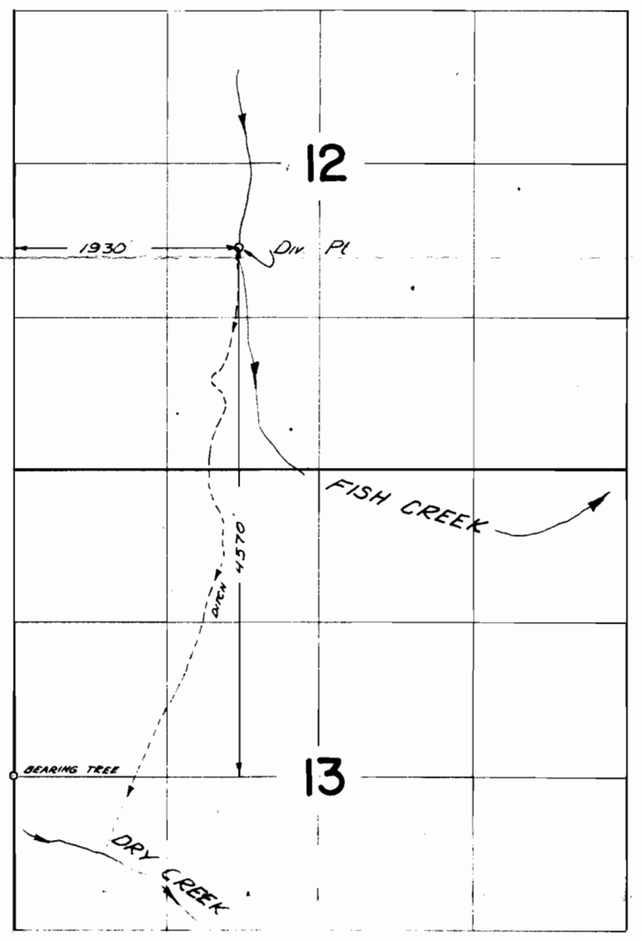

T.7S.
T.8S.

FINAL PROOF SURVEY

UNDER

~~Application nos.~~ R 25508 ~~Permit nos.~~ R 1116
25631 20175

IN NAME OF

FISH LAKE IMPROVEMENT DISTRICT

Surveyed Aug. 1,2,3, 1967 by V. Garner

Lands for which prior rights exist - supplemental

Primary irrigation

1967-D
