


T.5.S.R.I.E.W.M.

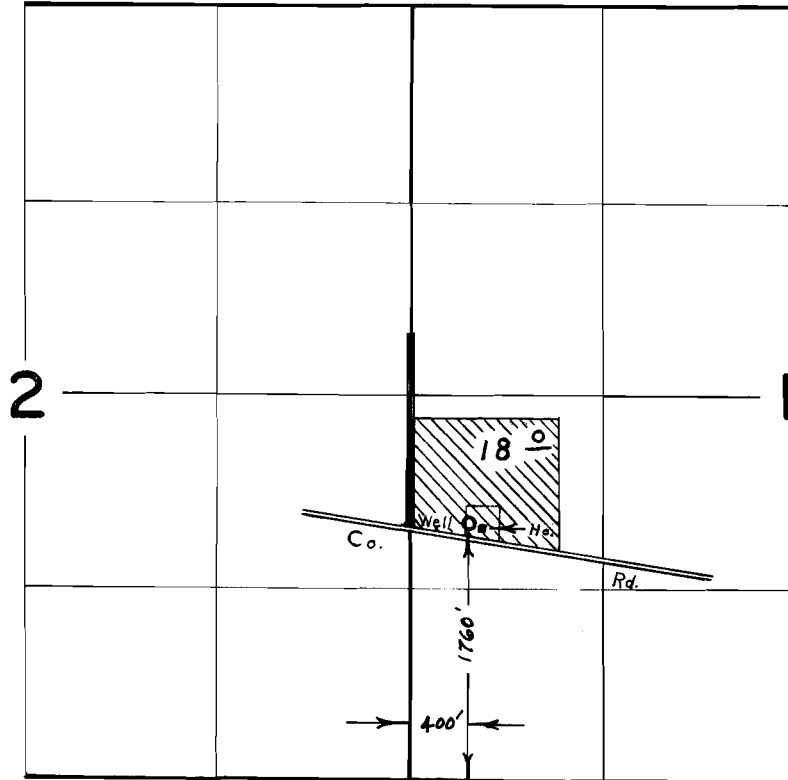

FINAL PROOF SURVEY UNDER

Application No. G-2850 Permit No. G-2653
IN NAME OF

ANTON J. PIRKL

Surveyed Sept. 30, 1966, by L. C. Gould