


T. 5 S. R. 1 E. W. M.

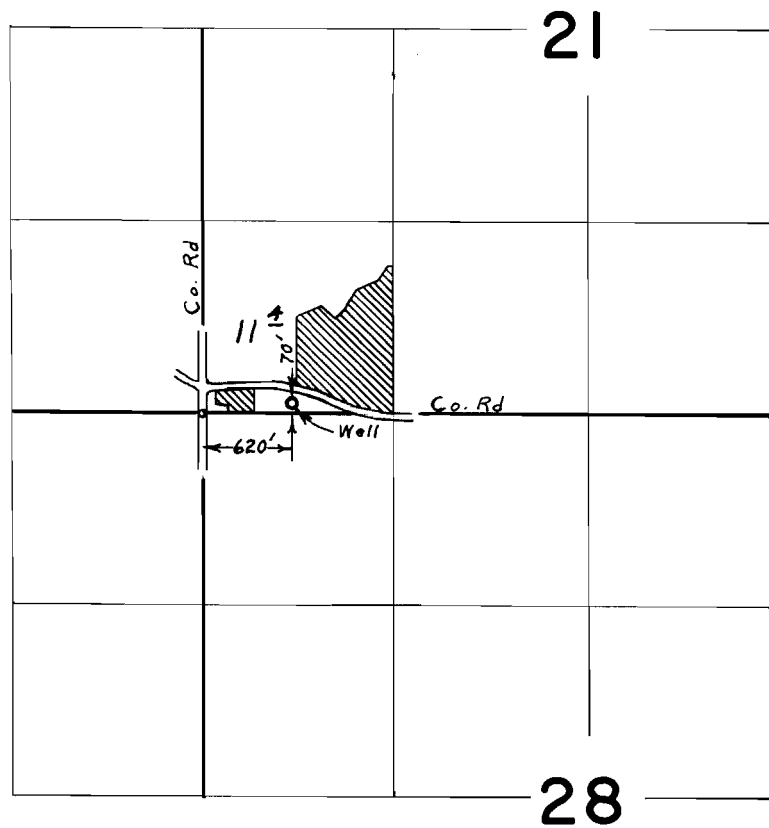

FINAL PROOF SURVEY
UNDER

Application No. G-3646 Permit No. G-3425
IN NAME OF
ERNEST KIMLINGER

Surveyed Oct. 17, 1967, by L. E. Gould