


T.5S.R.1E.W.M.

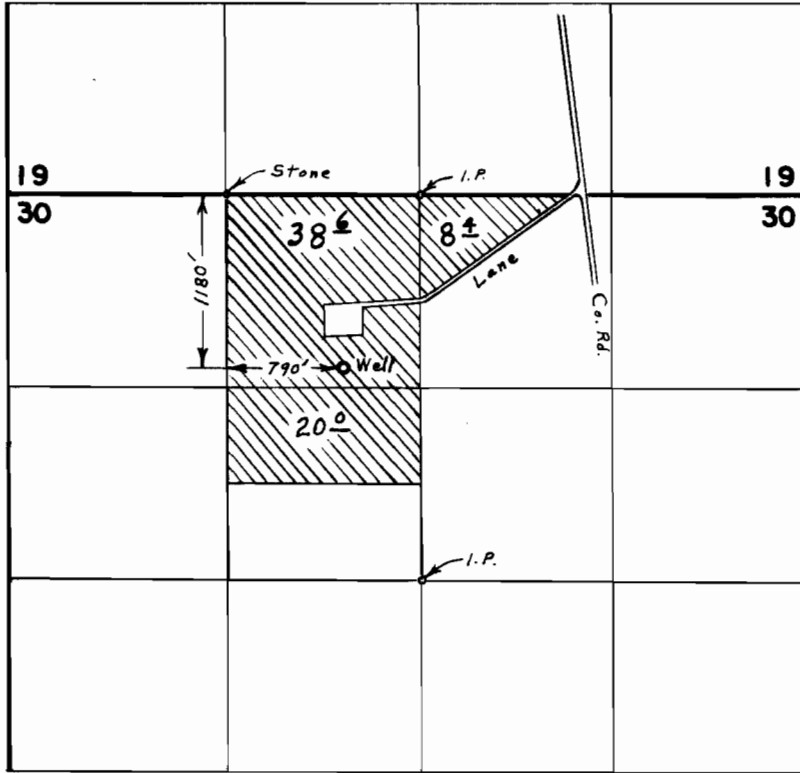

FINAL PROOF SURVEY UNDER

Application No. G-2282 Permit No. G-2108
IN NAME OF

GEORGE E. BOND

Surveyed Oct. 17, 1967, by R. E. Gould