


T. 5 S. R. 1 E. W. M.

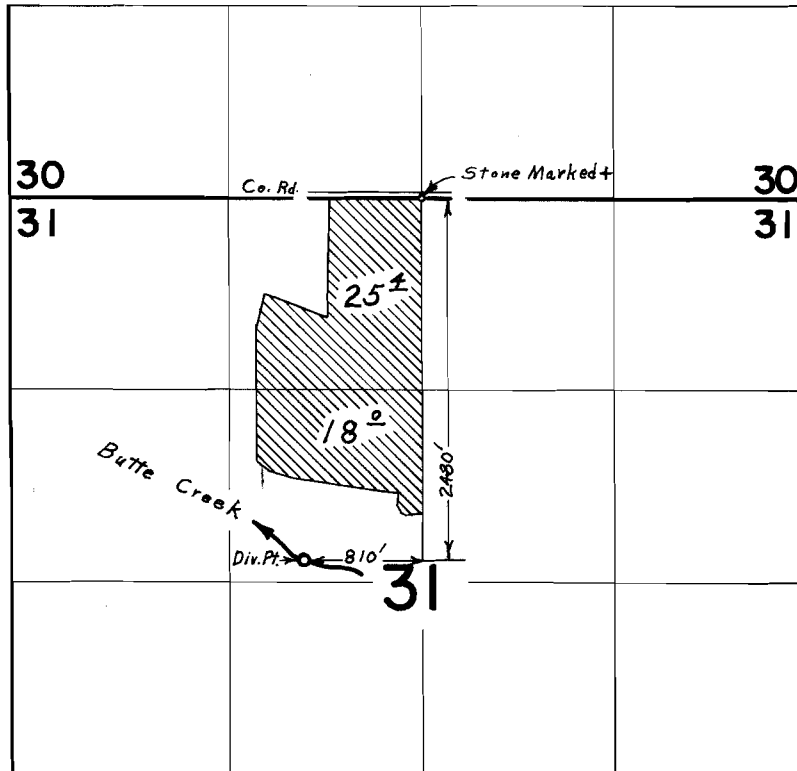

FINAL PROOF SURVEY UNDER

Application No. 40700 Permit No. 30318
IN NAME OF
GEORGE E. BOND

Surveyed Oct. 18, 1967, by L. E. Gould