


T. 25 S. R. 6 W. W.M.

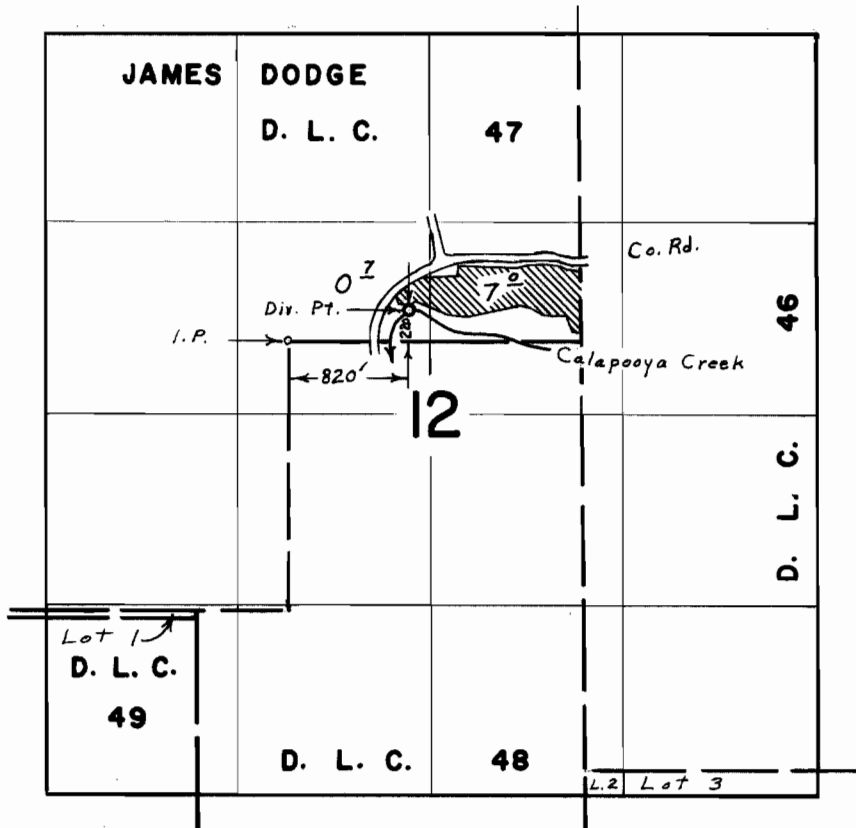

FINAL PROOF SURVEY UNDER

Application No. 40953 Permit No. 30430
IN NAME OF

GEORGE ALFRED TRUMBO

Surveyed June 13, 1967, by L. E. Gould