T.5&6S.R.1E.W.M.

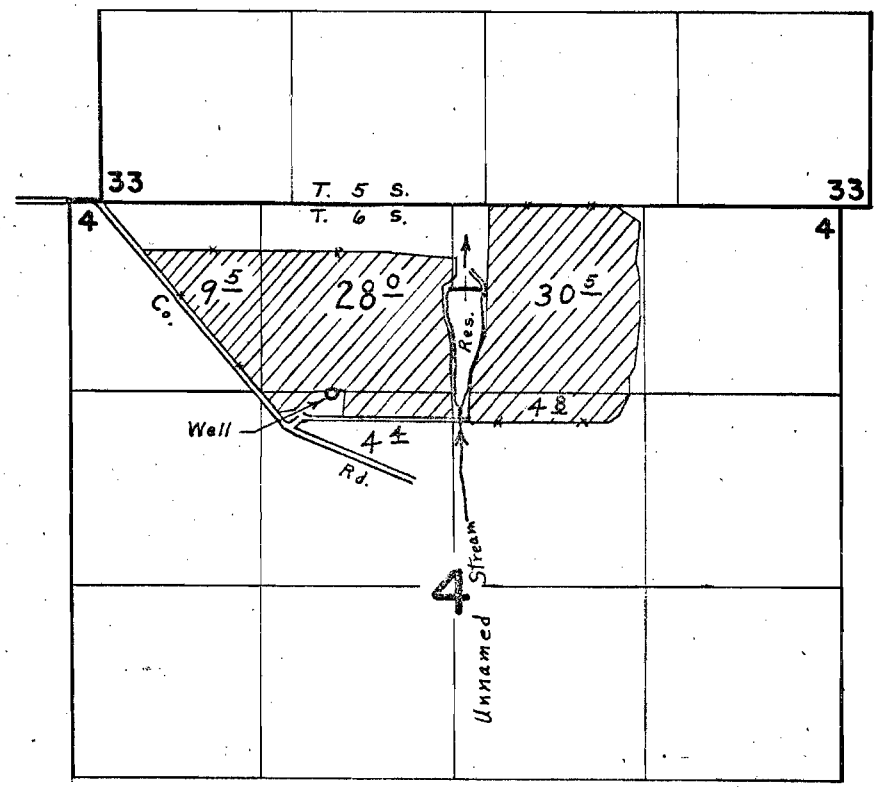

Div. PT. located 580' S. & 2700' E., Well, 1300's & 1780'E.
Both from N.W. Cor. Sec. 4

FINAL PROOF SURVEY
UNDER

G-2373 G-2299
R-37776 R-3160
Application No. 37777 Permit No. 28423
IN NAME OF

RAY SCHAEFER

Surveyed Sept 28 1966 Oct. 20 1967, by L. E. Gould

1967-W