


T.28S.R.11W.W.M.

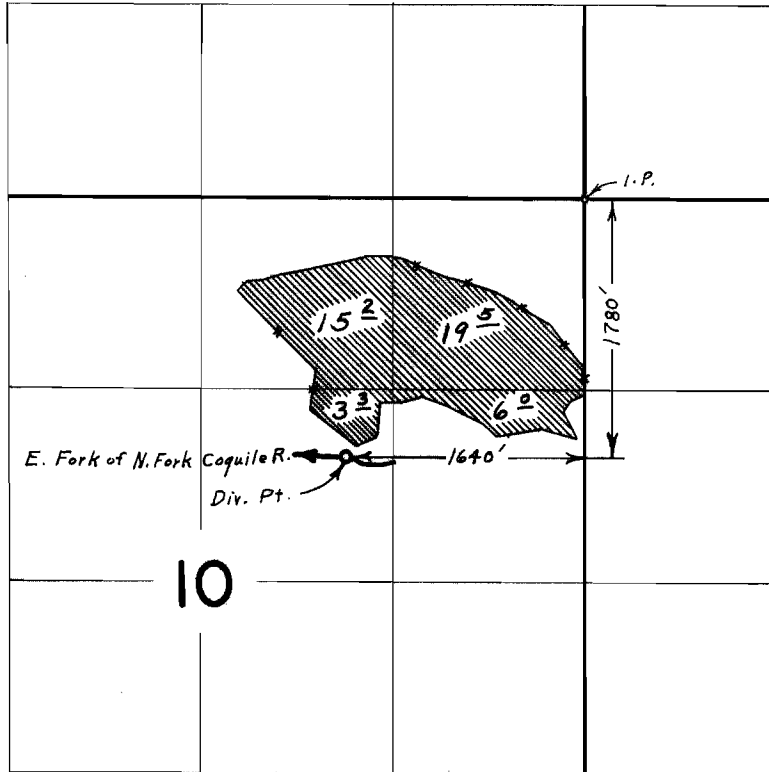

FINAL PROOF SURVEY UNDER

Application No. 39478 Permit No. 29308

IN NAME OF

J. V. KOSKI

Surveyed May 18, 1967., by L. E. Gould