


# T.28 S.R.12 W.W.M.

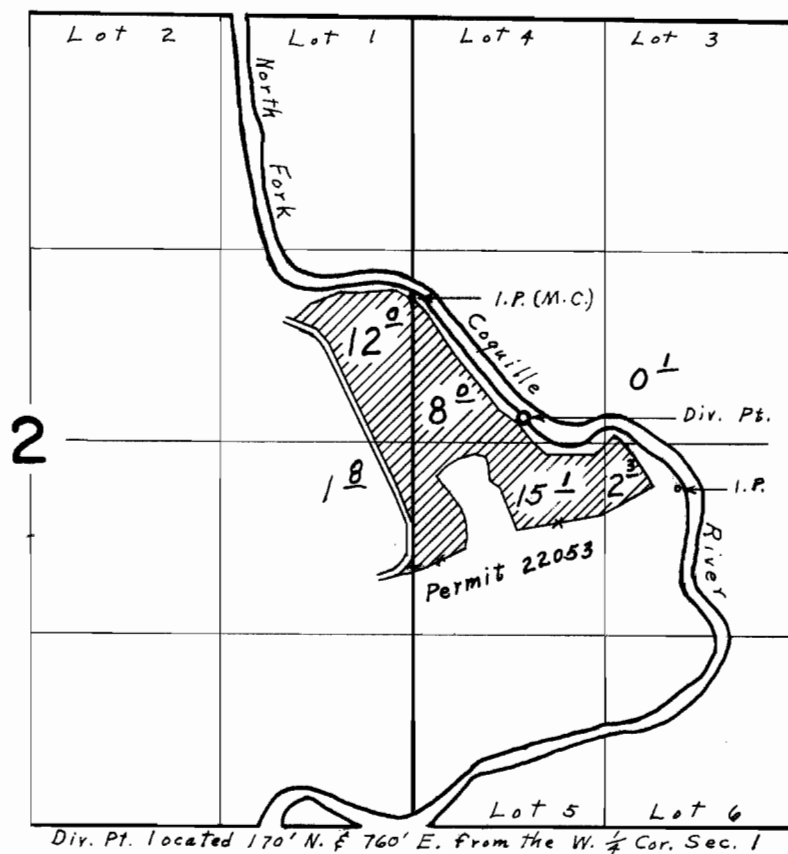

## FINAL PROOF SURVEY UNDER

Application No. 39616 Permit No. 29476  
IN NAME OF  
**HOLLIS MAST**

Surveyed May 23, 1967, by L. E. Gould