


T.25 S.R.11 W.W.M.

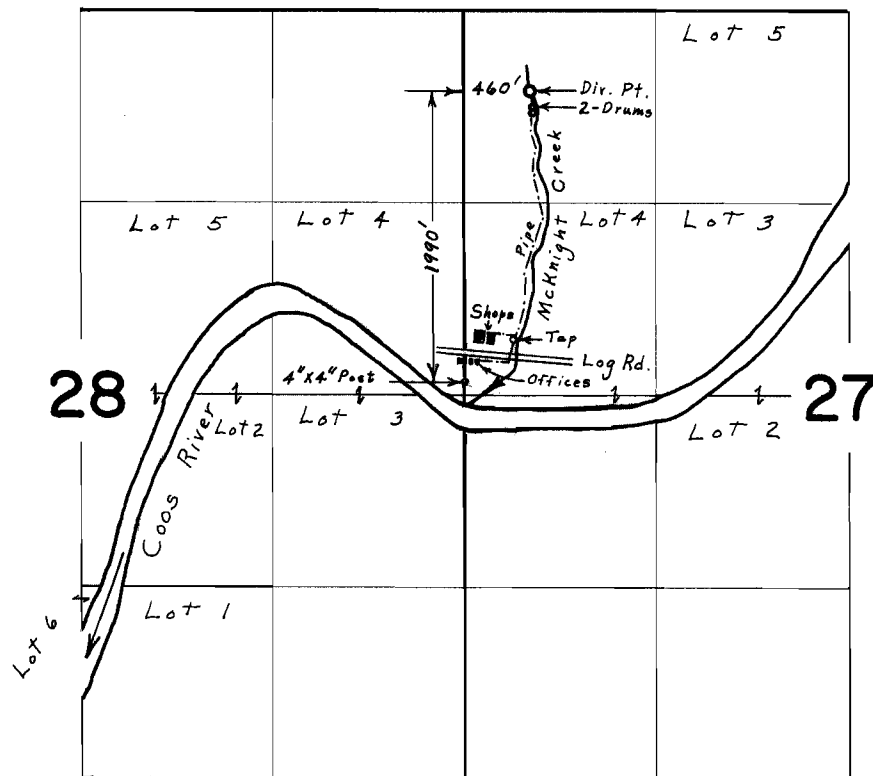

FINAL PROOF SURVEY
UNDER

Application No. 40011 Permit No. 29798
IN NAME OF

MENASHA CORPORATION

Surveyed May 17, 1967, by L. E. Gould