


T.28 S.R.11 W.W.M.

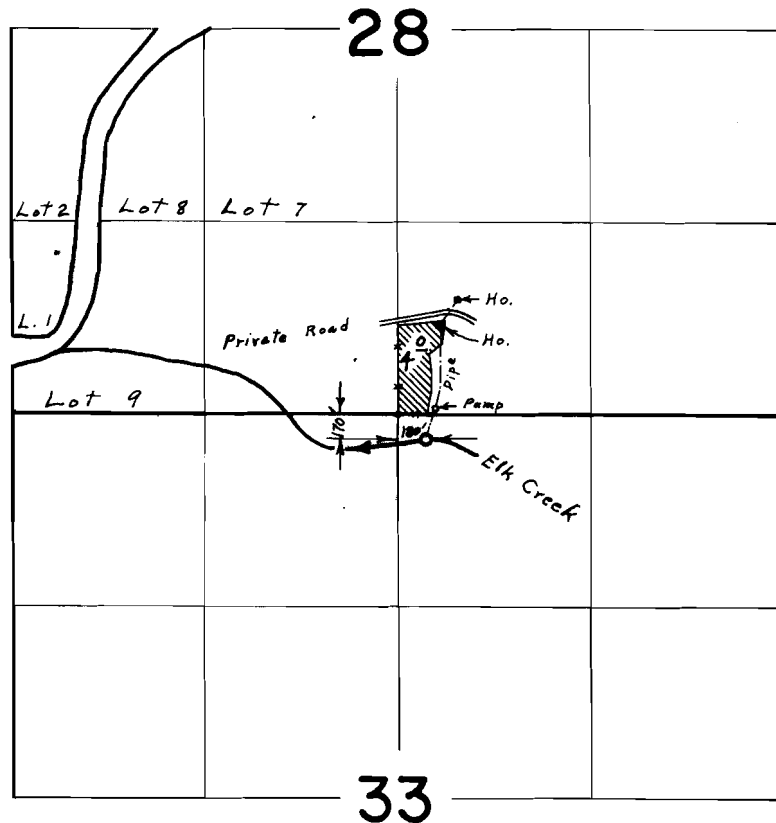

FINAL PROOF SURVEY
UNDER

Application No. 40679 Permit No. 30303
IN NAME OF
SANFORD N. RAY

Surveyed May 22, 1967, by L. E. Gould