


T. 29 S. R. 12 W. W.M.

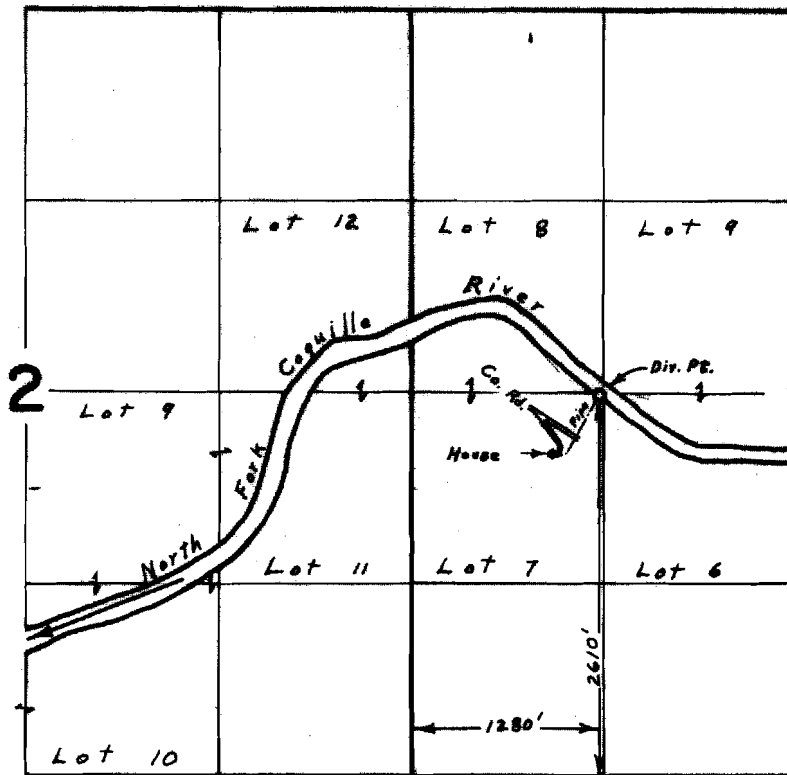

FINAL PROOF SURVEY UNDER

Application No. 42055 Permit No. 31479
IN NAME OF
CHESTER ZUMWALT

Surveyed May 22, 1967, by L. E. Gould