


T. 27 S. R. 11 W. W. M.

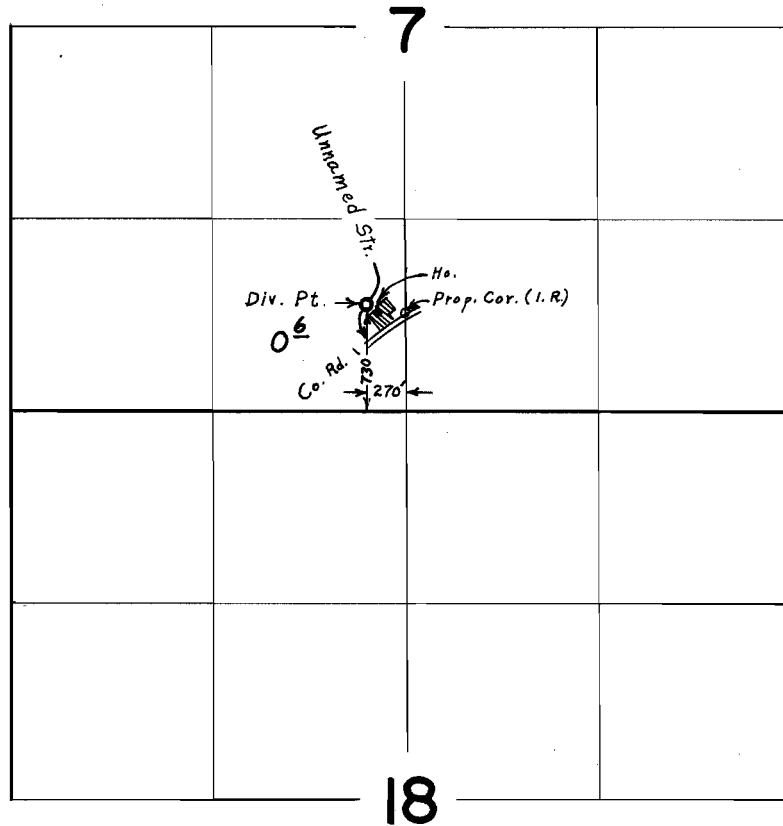

FINAL PROOF SURVEY UNDER

Application No. 42207 Permit No. 31571
IN NAME OF

WILLIAM A. FRAME

Surveyed May 16, 1967, by L. E. Gould