


T.28S. R.7W. W.M.

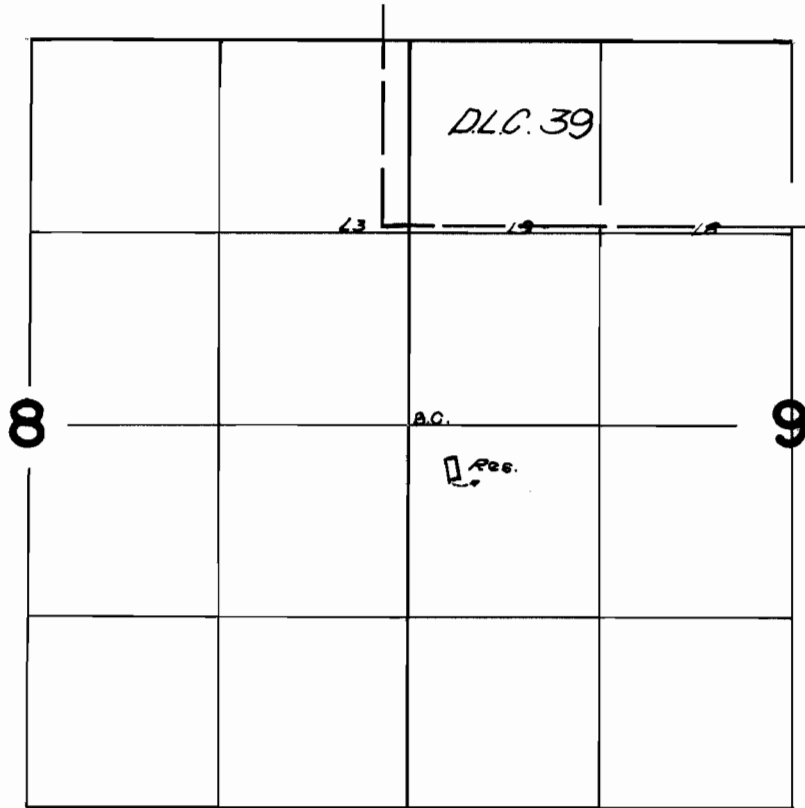

FINAL PROOF SURVEY UNDER

Application No. R-30074 Permit No. R-3154
IN NAME OF

WALTER B. SMITH

Surveyed April 21 1967, by V. Garner