


T. 25 & 26 S. R. 5 & 6 W. W. M.

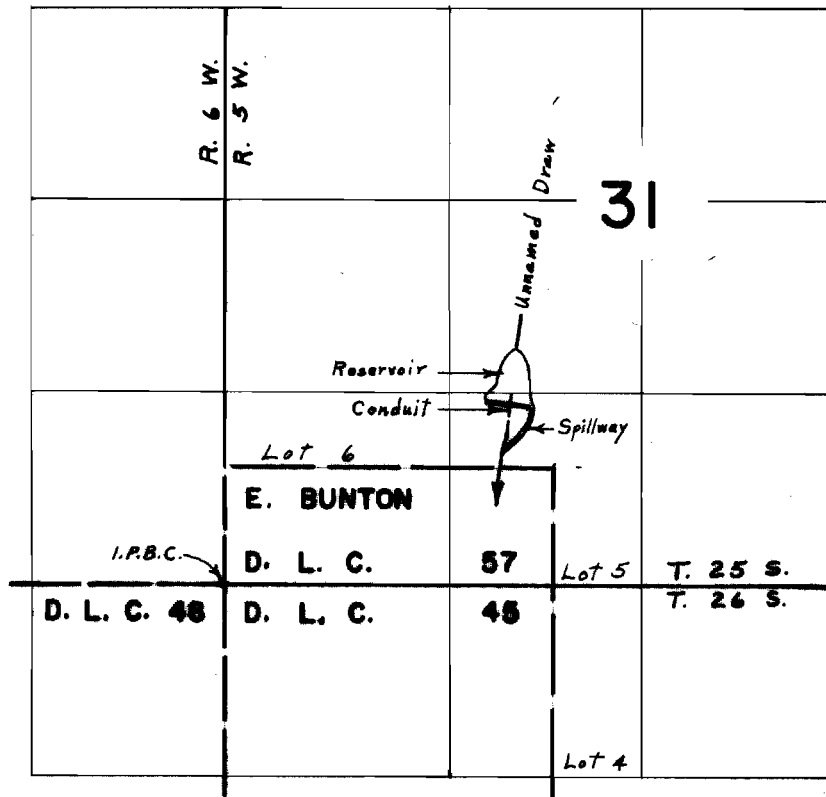

FINAL PROOF SURVEY UNDER

Application No. R-41464 Permit No. R-4595
 IN NAME OF
WILLIAM A. POTH

Surveyed June 9, 1967, by L. E. Gould