


# T. 25 & 26 S. R. 7 & 8 W. W.M.

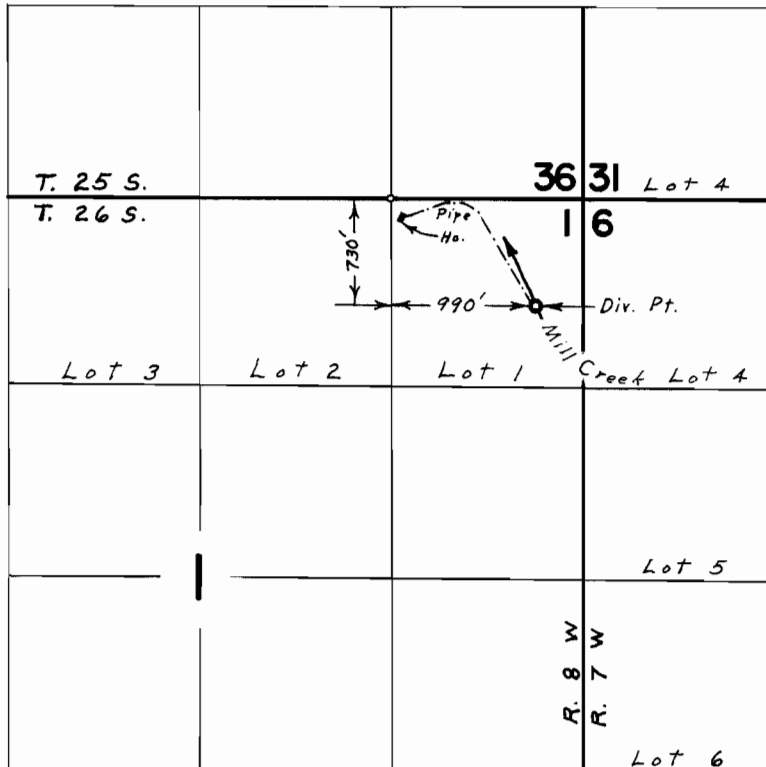

## FINAL PROOF SURVEY UNDER

Application No. 38629 Permit No. 28757  
IN NAME OF

**W. M. GRIER**

Surveyed June 7, 1967, by L. E. Gould